



**BUILDING ACCESS**  
**CONTROL**  
STUDY  
FOR  
**RESIDENCE HALL**  
**BUILDINGS**  
AND  
**ADJOINING DINING HALLS**



MAY 2004


GETTING




**BUILDING ACCESS CONTROL**  
STUDY  
FOR  
**RESIDENCE HALL BUILDINGS**  
AND  
**ADJOINING DINING HALLS**

**TABLE OF CONTENTS**

1. Executive Summary
2. Cost Summary
3. Notes and Symbol Key
4. Cost Breakdown By Building
5. Appendix No. 1 – Available Electric Power
6. Appendix No. 2 – Door Hardware Package Type
7. Appendix No. 3 – Building Floor Plans
8. Appendix No. 4 – Photographs

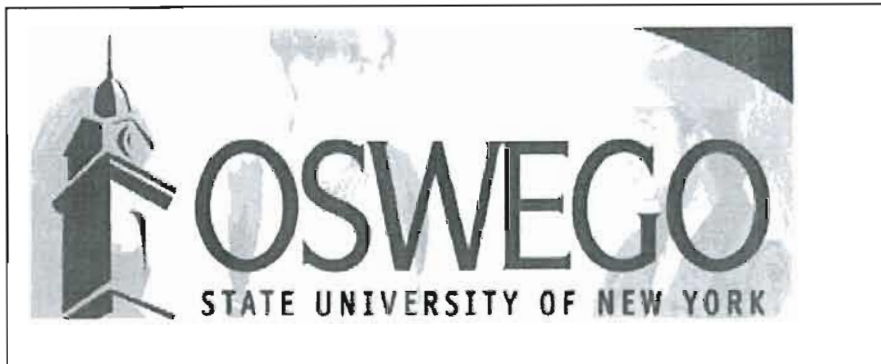

**Technical Analysis of Door and Door Hardware  
Requirements  
Access Control Feasibility  
April 30, 2004**

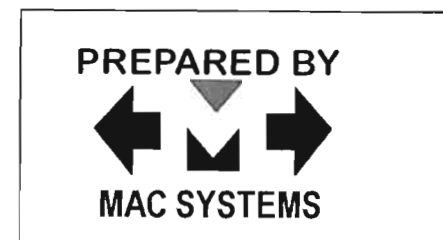

# **BUILDING ACCESS CONTROL**

## **STUDY FOR RESIDENCE HALL BUILDINGS AND ADJOINING DINING HALLS**

### **BUILDINGS SURVEYED**

- Lonis Hall
- Mackin Dining Hall
- Moreland Hall
- Funnelle Hall
- Cooper Dining Hall / Cooper Fitness Center
- Hart hall
- Seneca Hall
- Pathfinder Dining Hall
- Cayuga Hall
- Onondaga Hall
- Littlepage Dining Hall / Glimmerglass Fitness Center
- Oneida Hall
- Scales Hall
- Waterbury Hall
- ~~Riggs Hall~~ (under construction)
- ~~Lakeside Dining Hall~~(under construction)
- Johnson Hall



# Technical Analysis of Door and Door Hardware Requirements Access Control Feasibility

## SCOPE

MAC Systems conducted a survey of the perimeter doors of fifteen buildings on the State University of New York campus on April 21, 2004 and April 22, 2004. The buildings included twelve residence halls and three adjoining dining halls. A goal of the survey was to ascertain and define door hardware requirements and operational desires, in order to facilitate planning for access control implementation. Another survey goal was to define what access control components would be required for perimeter access control on these residence halls, as well as defining wiring requirements, wire paths, power backup requirements and options, availability of network space, and availability of power circuits in the network rooms. In order to provide a coordinated evaluation, representatives from facilities design and construction (FDC), facilities electrical dept, and facilities building trades participated, as well as two persons from MAC Systems acting in a consulting role. All access system equipment to be specified must have 100% compatibility and 100% integration with existing systems on campus, which means same access system brand and model as used elsewhere on campus. Likewise, the brands of hardware are those that the facilities department has confidence in. Accurate cost projections were developed to facilitate budget planning. An additional goal of this effort included defining the costs to run wiring such that any perimeter entrance (with the exception of exterior apartments) could have Closed Circuit Television (CCTV) equipment installed in either temporary or permanent applications by the process of connecting cameras and recording devices to the wiring. This may allow the infrastructure for CCTV to be implemented at a low cost by accompanying the access control wiring.

## DEFINITIONS OF DOOR TYPE, ACCORDING TO THEIR OPERATION

Each perimeter door of these buildings was designated to receive hardware and access control components in order to realize one of the following operational goals.

### ACCESS CONTROL OPERATED: EXTERIOR ACCESS BY CARD

With this type of door a person can present their college card to gain building access when doors are locked, if authorized to do so. These doors operate in the same ways that one traditionally associates with access control doors. Additionally, certain of these doors (primarily those associated with main entrances) are for the process of this study to be held unlocked but closed during daylight hours. During nighttime hours these doors would be locked and accessible only by card. Other doors, such as those located in the high traffic tunnels between the dorms and dining halls, may be manually held open by their fire release magnets during the day (the current practice), and would be shut at night and passage would require presentation of a valid card. It was stated by FDC that automated (non-manual) locking capability by command of the access system is required. In practice this means that the access system would be able to toggle the hardware between a day mode (auto unlocked) and a night mode (auto locked) without requiring a person to visit the doors to manually turn a dogging

cylinder or locking lever. This has a profound effect on hardware, requiring a migration from non-electrified to electrified hardware to accommodate this operational requirement.

Various types of doors require various electrified hardware to operate well, considering operational aspects such as reliability and service life, particularly as many of the affected doors have high usage. The hardware specified includes electrified panic hardware, electric strikes, and magnets. No single type of electrified hardware was suitable for all doors. Typical applications in this category include primary main doors, and back doors designated for authorized building entry from walkways and parking areas.

#### **2 ACCESS CONTROL OPERATED: NO EXTERIOR ACCESS BY CARD**

These type of doors are monitored by the access system against being propped open, or unauthorized opening, and they have both a local horn and signal a remote alert or alarm condition to the access system head end. The hardware is migrated to electrified control of hardware, so that the day mode (auto unlock by system) and night mode ( auto lock by system) is available. These doors also allow egress without activating an alarm condition, through the use of a PIR or exit bar switch. However, there is no exterior card reader. Typical applications include secondary main doors (those not designated to have a card reader controlling them).

#### **3 FULL ALARM ONLY**

These type of doors do not offer card access from the outside, and do not need control of the locking hardware (no electrified hardware). These doors are monitored by the access system against being propped open, or being forced open. Egress is allowed without causing alarm by use of a PIR. Propping or a forced door condition triggers a local horn and or alarm condition to the access system head end. Typical applications include secondary exits. This type is meant for doors designated for egress only.

#### **4 DOOR CONTACT ONLY**

This allows monitoring of the door by the access system. Any opening is noted and/or causes a local alarm and/or alarm condition to the access system head end. A typical application is a true emergency exit, which nobody is authorized to use except in an emergency, and where a "alarm will sound " sign would be expected.

### **OPERATIONAL ASSUMPTIONS**

These are the operational assumptions that we understand are set forth by SUNY Oswego FDC. Operational assumptions directly affect cost , primarily by requiring hardware changes, so alterations in operational assumptions may realize cost savings or cost increases from the costs used in this report.

#### **ASSUMPTION ONE : SYSTEM CONTROLLED DAY/NIGHT OR AUTO LOCK/AUTO UNLOCK CAPABILITY ON ALL ACCESS CONTROL OPERATED DOORS (BUT NOT ON FULL ALARM OR DOOR CONTACT DOORS)**

All doors where the access control system controls locking of the door (card entry or not) will have electrified hardware control (electrified hardware, strike or magnetic lock ) such that the door may transition between a "locked door" to an "unlocked door", and vice versa, without a person visiting the door. "

## **ASSUMPTION TWO: POWER FAILURE OPERATION**

All access control doors where exterior card access is available shall operate for a minimum of 4 hours by battery back up in the locked (entry only by card) mode, in the absence of main or generator power. Requirements for desired hours of battery backed operation in the auto unlock mode must be defined by the school, and when done so an appropriate quantity of batteries can be determined to meet the power usage for the desired time. Likewise, if it is desired to automatically transition from an automatic open mode to a locked mode anytime an AC power failure is experienced, this operational desire must be defined by the school. MAC Systems will investigate and report back what might be required (software and/or hardware) to have this feature, and whether there would be a cost: in any case it is not a feature offered by the system at the moment.

All access control doors where exterior access by card is not available shall not be battery backed up. In the case that they are not on a generator circuit, they will revert to being locked when power fails. In general, this means that during an AC failure all secondary main entrance doors will lock even if they were in a free entry mode when the power failure occurred. The main entry doors that are controlled by card readers will remain held open if in the hold open mode until battery back up is exhausted (if not on a generator circuit), or if in the locked mode (entry by card swipe only) then they will operate normally by card swipe for a minimum of 4 hours.

## **ASSUMPTION THREE: POWER SOURCES**

Power for the Access System Power Supply will be available from the electric outlet in the individual building's room which houses the campus network equipment. These rooms may include circuits that have generator back up, and ones that do not. This outlet is located at the network equipment Building Distribution Frame (BDF) rack, and has available space as observed during the survey.

Power for the electrified hardware power supply will be available from an electrical panel breaker in the BDF room, when available, or from the existing rack outlet. See list of available panels provided by the campus.

## **ASSUMPTION FOUR: MAIN INNER AND OUTER ENTRANCE DOORS CONTROLLED**

On main entrances where there are two banks of doors with a foyer between, both sets of doors (inner and outer doors) shall be controlled by the access system (as defined in assumption one) and only one door set consisting of a right hand leaf and left hand leaf of one inner and one outer door shall have card entry .

Typical operation: when in the auto locked mode, all exterior doors will be locked. Upon presentation of a valid authorized card, one exterior door set consisting of a right hand leaf and a left hand leaf will be unlocked, permitting entry to the foyer. All inner foyer doors shall be locked. Upon presentation of a valid authorized card, one interior door set consisting of a right hand leaf and a left hand leaf shall be unlocked, allowing entry to the building.

## ASSUMPTION FIVE : CCTV WIRING OPTION

Costing provide to add CCTV wiring assumes the work is being done at the same time as access control installation, as a cost savings over two separate efforts.

## ASSUMPTION SIX

Costing is based on the contractor being allowed to work Monday through Friday between 7AM and 5 PM, and on the full scope being done as one phase during a continuous time frame.

## THE IMPORTANCE OF QUALITY HARDWARE

It is very important in undertaking an access control implementation that the electrified hardware component be of a quality and be matched to the application such that the original architectural hardware longevity, cycle life, and freedom from trouble be maintained as much as possible. It must be considered that access control doors get more and not less comment and scrutiny than mechanical doors when they do not latch, close, lock, or unlock. Even though it may be the same door a year later, an access door that does not secure the entrance may be more of a potential liability than the same door with mechanical hardware was: the yardstick of expectation, performance, and the perceived importance of the door has likely been raised.

Most facility departments have probably learned that the cheapest exit device that will fit and the cheapest hinges that will fit are unacceptable. The cost and aggravation to deal with the fallen apart exit device and the sagging, dragging, non-latching door always far exceeds any savings of sub standard hardware.

The cheapest access control hardware solutions are likewise probably unacceptable. After all, the high use and pressure on hardware performance of main entrance doors don't diminish just because a card reader is hung on them. For example, in theory the cheapest method of providing an electrical control for vertical rod exit devices might be an electrical strike for vertical rod exit devices. But we know that they have a very short expected life span in any college application , are fragile and prone to breakage, promote warped and torque damaged doors because they only secure the door by one top rod, are prone to damaging the exit device which was designed to secure the door with top and bottom rods and not just the top rods, stay adjusted for a short time, and are hard to install and adjust. We might turn down a project specified this way, because the project cannot reflect well on our professionalism. In our opinion, and in that of many college security consultants and architects, it is better to compromise on the project scope rather than compromise on the operational integrity of the hardware.

## POTENTIAL INITIAL SYSTEM COST SAVINGS

In a retrofit project, where exerting system automated control over doors means replacing non-electrified hardware with electrified hardware the access system can control, this hardware replacement is a significant part of the access control implementation costs.

In this study, there are two major areas of cost where "convenience" (and associated operational parameters) entail a significant cost burden.



## **1. AUTOMATED LOCKING & UNLOCKING**

There are a significant number of doors (primarily main entrance doors) that currently appear to transition from locked to unlocked modes manually by somebody going to the door and mechanically operating a dogging cylinder, and most of these are designated to get automated control and monitoring (but not entry by card) at a significant cost over retaining manual control. Automated control is the correct and ideal operational goal, because it eliminates the human factor in whether doors are secure, or keys are lost, and replaces it with system control. However, retained manual control at some doors is a potential option for cost savings.

## **2. INNER DOOR AND OUTER DOOR CONTROL OF MAIN ENTRANCES**

As specified, both the inner and outer sets of doors at main entrances receive access system control and associated electrified hardware. In many cases that entails 12 or more sets of electrified hardware. From the standpoint of student personal security and convenience this is a correct and ideal operational goal. It means that a student with a valid college card could visit a student in a dorm that was not their residence at night, enter the dorm foyer with their card, but not be able to enter through the inner door, and be able to telephone the resident to let them in from a heated and locked foyer.

However, in order to meet the less ambitious goal of a building perimeter secured by access control, only one set of doors (inner foyer or outer perimeter doors) need be secured, which is an option to reduce the transitioning to electrified hardware significantly, with associated reduced costs.

**SUMMARY OF COSTS FOR BUILDING  
ACCESS CONTROL**

30-Apr-04

<b>RESIDENCE HALL PERIMETER CONTROL</b>		
<b>BUILDING</b>	<b><u>perimeter</u> <u>access control</u> <u>cost</u></b>	<b><u>front desk</u> <u>monitor panel</u></b>
LONIS	\$ 13,922	\$ 1,750
MACKIN	\$ 25,338	\$ 1,750
MORELAND	\$ 12,911	\$ 1,750
FUNNELLE	\$ 38,614	\$ 3,000
COOPER	\$ 31,982	n/a
HART	\$ 21,111	existing
SENECA	\$ 47,593	\$ 1,750
PATHFINDER	\$ 24,557	n/a
CAYUGA	\$ 59,418	\$ 1,750
ONONDAGA	\$ 52,434	\$ 1,750
LITTLEPAGE	\$ 13,600	n/a
ONEIDA	\$ 65,493	\$ 1,750
SCALES	\$ 28,767	\$ 1,750
WATERBURY	\$ 34,621	\$ 1,750
JOHNSON	\$ 18,057	existing

\$ 488,418.00    \$ 18,750.00 (furnish & install)

**\$ 507,168** total furnish & install cost

\$ 25,358 contingency (@ 5%)

\$ 5,325 spare parts (@ 1%)

\$ 3,500 as-built drawings

\$ 70,375.72 design and contract services

( at 13 % of above costs)

---

**\$ 611,727 TOTAL PROJECT COST**  
**RESIDENCE HALL PERIMETER**

**Supplemental Pricing:**

The cost for conversion of the existing stand-alone card readers, on floors 2-9 of Hart Hall, to be connected to campus system is included as a separate spread sheet in this report. The cost for this work is estimated to be \$ 60,950.

Oswego State  
Residence Hall  
Building Access Control  
Study

**NOTES:**

1. See attached drawings to identify locations of doors listed in building spreadsheet.
2. Cost for locations with CCTV include 18-2 and RG59 cable with ends installed. CCTV only included for locations with card access. Add \$210 each for additional locations.
3. Access control panel and CCTV cables will be run to the room that currently houses the campus network rack. Wall space for mounting equipment and coiling CCTV cables appears to be available.
4. Electric hardware fails locked and magnetic locks fail unlocked upon loss of all power.
5. Magnetic lock locations include cost for required connection to fire alarm system and electrical over ride.
6. One front desk monitor panel can accommodate up to seven door locations each. Two panels may be used. Cost for one panel is \$1750 and cost for two panels is \$3000.
7. Cost includes all required patching and painting.
8. Cost includes all material and labor for a complete installation. Labor provisions for prevailing wages.
9. Cost includes all system programming, staff training and operation & maintenance manuals.
10. Construction duration estimated to be 6-8 months, after award of contract.
11. The access control at Funnelle Hall, from the basement of Cooper Dining Hall needs further investigation by the campus. There may be fire egress routes dictated by code that cannot be interrupted by installing a card reader control point in this area. This budget estimate is based on using existing doors at this location. Additional cost may be required based upon the final code interpretation.
12. See attached listing of the various hardware groups to identify what is included in each group.

**KEY:**

CA =	card access group
FA =	fully alarmed group
CO =	contact only group
PROX =	proximity card reader
PIN/PROX =	proximity card reader with PIN keypad

LONIS HALL

Building	Door #	Type	Door Package Type	Reader Style	CCTV ready	Budget \$	Notes:
Lonis	BDF		BDF PACKAGE			\$ 2,900.00	
	1	CA	STANDARD STRIKE PAC	PIN PROX	YES	\$ 2,518.00	exit device needs maint. by campus
	2	CA	STANDARD STRIKE PAC	PIN PROX	YES	\$ 2,518.00	exit device needs maint. by campus
	3	CA	STANDARD STRIKE PAC	PIN PROX	YES	\$ 2,518.00	
	4	CA	STANDARD STRIKE PAC	PIN PROX	YES	\$ 2,518.00	exit device needs maint. by campus
			PROJECT MANAGEMENT			\$ 950.00	
						<b>\$ 13,922.00</b>	

MACKIN HALL

Building	Door #	Type	Door Package Type	Reader Style	CCTV ready	Budget \$	Notes:
Mackin	BDF		BDF PACKAGE			\$ 2,900.00	
	1	CA	STANDARD STRIKE PAC	PIN PROX	YES	\$ 2,518.00	
	2	CA	MAG-LOCK PACKAGE	PIN PROX	YES	\$ 3,143.00	
	3	-	N/A	N/A	N/A		
	4	CA	MAG-LOCK PACKAGE	PIN PROX	YES	\$ 3,143.00	
	5	CA	MAG-LOCK PACKAGE	PIN PROX	NO	\$ 2,933.00	
	6	-	N/A	N/A	N/A		
	7	CA	MAG-LOCK PACKAGE	PIN PROX	NO	\$ 2,933.00	
	8	DC	DOOR CONTACT PACKAGE	N/A	NO	\$ 494.00	DOOR CONTACT TO NEAREST DCD
	9	DC	DOOR CONTACT PACKAGE	N/A	NO	\$ 494.00	exit device needs maint. by campus
	10	CA	STANDARD STRIKE PAC	PROX	YES	\$ 2,518.00	NEED NEW MORTISE LOCK
	11	DC	DOOR CONTACT PACKAGE	N/A	NO	\$ 494.00	
12	CA	STANDARD STRIKE PAC	PROX	YES	\$ 2,518.00	getting new door/frame by campus2004	
			PROJECT MANAGEMENT			\$ 1,250.00	
						<b>\$ 25,338.00</b>	

**MORELAND HALL**

<b>Building</b>	<b>Door #</b>	<b>Type</b>	<b>Door Package Type</b>	<b>Reader Style</b>	<b>CCTV ready</b>	<b>Budget \$</b>	<b>Notes:</b>
Moreland	BDF		BDF PACKAGE			\$ 2,900.00	
	1	CA	STANDARD STRIKE PAC	PIN PROX	YES	\$ 2,518.00	
	2	FA	FULLY ALARMED - EXIT ONLY	N/A	NO	\$ 1,507.00	
	3	CA	STANDARD STRIKE PAC	PIN PROX	YES	\$ 2,518.00	EXIT DEVICE TO BE REPLACED <i>By Campus</i>
	4	CA	STANDARD STRIKE PAC	PIN PROX	YES	\$ 2,518.00	EXIT DEVICE TO BE REPLACED <i>By Campus</i>
			PROJECT MANAGEMENT			\$ 950.00	
						<b>\$ 12,911.00</b>	

**FUNNELLE HALL**

<b>Building</b>	<b>Door #</b>	<b>Type</b>	<b>Door Package Type</b>	<b>Reader Style</b>	<b>CCTV ready</b>	<b>Budget \$</b>	<b>Notes:</b>
Funnelle	BDF		BDF PACKAGE			\$ 2,900.00	
	1	FA	FULLY ALARMED - EXIT ONLY	N/A	NO	\$ 1,507.00	
	2	FA	FULLY ALARMED - EXIT ONLY	N/A	NO	\$ 1,507.00	
	3	FA	FULLY ALARMED - EXIT ONLY	N/A	NO	\$ 1,507.00	
	4	CA	SURFACE VERTICAL ROD 1	PIN PROX	YES	\$ 7,740.00	
	5	CA	SURFACE VERTICAL ROD 2	PIN PROX	NO	\$ 6,567.00	
	6	FA	FULLY ALARMED - EXIT ONLY	N/A	NO	\$ 1,507.00	
	7	CA	SURFACE VERTICAL ROD 1	PIN PROX	YES	\$ 7,740.00	TIE INTO EXISTING ADA OPENERS.
	8	FA	FULLY ALARMED - EXIT ONLY	N/A	NO	\$ 1,507.00	
	9	CA	MAG-LOCK DOOR	PIN PROX	YES	\$ 3,375.00	exit device needs maint. by campus
	10	FA	FULLY ALARMED - EXIT ONLY	N/A	NO	\$ 1,507.00	
	11	-	need campus code determination	N/A	N/A		Wrong door swing - see Cooper # 4
			PROJECT MANAGEMENT			\$ 1,250.00	
						<b>\$ 38,614.00</b>	

COOPER DINING HALL

Building	Door #	Type	Door Package Type	Reader Style	CCTV ready	Budget \$	Notes:
Cooper		BDF	BDF PACKAGE			\$ 2,900.00	
	1	CA	SURFACE VERTICAL ROD 1	PIN PROX	YES	\$ 7,740.00	TIE INTO EXISTING ADA OPENERS.
	2	CA	SURFACE VERTICAL ROD 2	PIN PROX	YES	\$ 6,567.00	TIE INTO EXISTING ADA OPENERS.
	3	CA	SURFACE VERTICAL ROD 1	N/A	NO	\$ 7,740.00	
	4	CA	TUNNEL DBL DR PACKAGE	PIN PROX	YES	\$ 4,841.00	Problem! opposing door swing - exit issue
	5 AND 6	FA	FULLY ALARMED - EXIT ONLY	N/A	NO	\$ 750.00	5 AND 6 SHARING DCD AND HORN
	7	DC	DOOR CONTACT PACKAGE	N/A	NO	\$ 494.00	ELECTIC ROOM 2 CONTACTS.
			PROJECT MANAGEMENT			\$ 950.00	
					<b>\$ 31,982.00</b>		

HART HALL

Building	Door #	Type	Door Package Type	Reader Style	CCTV ready	Budget \$	Notes:
Hart			New Millenium supply	N/A	N/A	\$ 354.00	ADDITIONAL POWER SUPPLY NEEDED
	1	FA	FULLY ALARMED - EXIT ONLY	N/A	NO	\$ 650.00	PULL 22/6 FOR NEW DS-160/W HORN
	2	FA	FULLY ALARMED - EXIT ONLY	N/A	NO	\$ 650.00	PULL 22/6 FOR NEW DS-160/W HORN
	3	FA	FULLY ALARMED - EXIT ONLY	N/A	NO	\$ 650.00	PULL 22/6 FOR NEW DS-160/W HORN
	4	FA	FULLY ALARMED - EXIT ONLY	N/A	NO	\$ 650.00	PULL 22/6 FOR NEW DS-160/W HORN
	5	FA	FULLY ALARMED - EXIT ONLY	N/A	NO	\$ 650.00	PULL 22/6 FOR NEW DS-160/W HORN
	6	FA	FULLY ALARMED - EXIT ONLY	N/A	NO	\$ 650.00	PULL 22/6 FOR NEW DS-160/W HORN
	7	CA	SURFACE VERTICAL ROD 1	PIN PROX	Y	\$ 7,740.00	ADD NEW ACCESS PIONT TO SYS
	8	FA	FULLY ALARMED - EXIT ONLY	N/A	NO	\$ 650.00	PULL 22/6 FOR NEW DS-160/W HORN
	9	FA	FULLY ALARMED - EXIT ONLY	N/A	NO	\$ 650.00	PULL 22/6 FOR NEW DS-160/W HORN
	10	CA	SURFACE VERTICAL ROD 2	PIN PROX	Y	\$ 6,567.00	ADD NEW ACCESS POINT TO SYS
		PROJECT MANAGEMENT			\$ 1,250.00		
					<b>\$ 21,111.00</b>		
						<i>THE \$650 COST IS TO PROVIDE AND WIRE NEW P.I.R. WITH LOCAL ALARM HORN AT EACH DOOR NOTED.</i>	

SENECA HALL

Building	Door #	Type	Door Package Type	Reader Style	CCTV ready	Budget \$	New Door \$	Notes:
Seneca		BDF	BDF PACKAGE			\$ 2,900.00		
	1	FA	FULLY ALARMED - EXIT ONLY	N/A	NO	\$ 1,507.00		
	2	CA	APARTMENT PACKAGE	PROX	NO	\$ 2,066.00		CYL LOCK
	3	CA	SURFACE VERTICAL ROD 1	PIN PROX	YES	\$ 7,740.00		REPLACE CURRENT PHI SVR
	4	FA	SURFACE VERTICAL ROD 3	N/A	NO	\$ 6,658.00		REPLACE CURRENT PHI SVR
	5	FA	SURFACE VERTICAL ROD 4	N/A	NO	\$ 6,237.00		REPLACE CURRENT PHI SVR
	6	CA	SURFACE VERTICAL ROD 2	PIN PROX	NO	\$ 6,567.00		REPLACE CURRENT PHI SVR
	7	CA	APARTMENT PACKAGE	PROX	NO	\$ 2,066.00		CYL LOCK
	8	CA	APARTMENT PACKAGE	PROX	NO	\$ 2,066.00		CYL LOCK
	9	CA	STANDARD STRIKE PACKAGE	PIN PROX	YES	\$ 2,518.00	\$3,500.00	RECOM. NEW DOOR/FRAME/HWDR
	10	CA	STANDARD STRIKE PACKAGE	PIN PROX	YES	\$ 2,518.00		getting new door/frame by campus2004
			PROJECT MANAGEMENT			\$ 1,250.00		
						<b>\$47,593.00</b>		<< TOTAL INCLUDES NEW #9 DOOR

PATHFINDER DINING HALL

Building	Door #	Type	Door Package Type	Reader Style	CCTV ready	Budget \$	New Door \$	Notes:
Pathfinder		BDF	BDF PACKAGE			\$ 2,900.00		
	1	CA	TUNNEL DBL. DR PACKAGE	PIN PROX	YES	\$ 4,841.00	\$3,500.00	RECOM. CONTROL POINT DOOR HERE
	2	CA	STANDERD STRIKE PACKAGE	PIN PROX	YES	\$ 2,518.00		getting new door/frame by campus2004
	3	FA	FULLY ALARMED - EXIT ONLY	N/A	NO	\$ 1,507.00		
	4	CA	TUNNEL DBL. DR PACKAGE	PIN PROX	YES	\$ 4,841.00	\$3,500.00	RECOM. CONTROL POINT DOOR HERE
	5	-						location does not work as control point
	6	-						location does not work as control point
			PROJECT MANAGEMENT			\$ 950.00		
						<b>\$24,557.00</b>		<< TOTAL INCLUDES NEW #1&4 DOOR

CAYUGA HALL

Building	Door #	Type	Door Package Type	Reader Style	CCTV ready	Budget \$	Notes:
Cayuga	BDF		BDF PACKAGE			\$ 2,900.00	
	1	CA	STANDARD STRIKE PACKAGE	PIN PROX	YES	\$ 1,507.00	getting new door/frame by campus2004
	2	FA	FULLY ALARMED - EXIT ONLY	N/A	NO	\$ 2,018.00	
	3	CA	APARTMENT PACKAGE	PROX	NO	\$ 2,518.00	MORTISE, 652
	4	CA	<del>APARTMENT PACKAGE</del>	<del>PROX</del> N/A	NO	<del>\$ 2,518.00</del>	MORTISE, 652
	5	CA	SURFACE VERTICAL ROD -1	PIN PROX	YES	\$ 7,740.00	REPLCAE PHI SVR DEVICES
	6	CA	SURFACE VERTICAL ROD -2	PIN PROX	NO	\$ 6,567.00	REPLCAE PHI SVR DEVICES
	7	FA	SURFACE VERTICAL ROD-4	N/A	NO	\$ 6,237.00	REPLCAE PHI SVR DEVICES
	8	CA	APARTMENT PACKAGE	PROX	NO	\$ 2,518.00	MORTISE, 652
	9	FA	FULLY ALARMED - EXIT ONLY	N/A	NO	\$ 1,507.00	
	10	CA	SURFACE VERTICAL ROD -1	PIN PROX	YES	\$ 7,740.00	getting new door/frame by campus2004
	11	CA	SURFACE VERTICAL ROD -1	PIN PROX	YES	\$ 7,740.00	getting new door/frame by campus2004
	12	FA	SURFACE VERTICAL ROD -3	N/A	NO	\$ 6,658.00	getting new door/frame by campus2004
			PROJECT MANAGEMENT			\$ 1,250.00	
						<b>\$59,418.00</b>	

*SURFACE VERT.  
ROD #3*

*6652*

ONONDAGA HALL

Building	Door #	Type	Door Package Type	Reader Style	CCTV ready	Budget \$	Notes:
Onondaga	BDF		BDF PACKAGE			\$ 2,900.00	
	1	FA	FULLY ALARMED - EXIT ONLY	N/A	NO	\$ 1,507.00	MORTISE LOCK
	2	CA	APARTMENT PACKAGE	PROX	NO	\$ 2,066.00	MORTISE LOCK, 652 STRIKE
	3	FA	SURFACE VERTICAL ROD 3	N/A	NO	\$ 6,658.00	REPLACE CURRENT PHI SVR
	4	CA	SURFACE VERTICAL ROD 1	PIN PROX	YES	\$ 7,740.00	REPLACE CURRENT PHI SVR
	5	FA	SURFACE VERTICAL ROD 2	PIN PROX	NO	\$ 6,567.00	REPLACE CURRENT PHI SVR
	6	FA	SURFACE VERTICAL ROD 4	N/A	NO	\$ 6,237.00	REPLACE CURRENT PHI SVR
	7	CA	APARTMENT PACKAGE	PROX	NO	\$ 2,066.00	MORTISE LOCK, 652 STRIKE
	8	CA	APARTMENT PACKAGE	PROX	NO	\$ 2,066.00	MORTISE LOCK, 652 STRIKE
	9	CA	STANDARD STRIKE PACKAGE	PIN PROX	YES	\$ 2,518.00	getting new door/frame by campus2004
	10	CA	STANDARD STRIKE PACKAGE	PIN PROX	YES	\$ 2,518.00	getting new door/frame by campus2004
	11	CA	TUNNEL DBL. DR PACKAGE	PIN PROX	YES	\$ 4,841.00	\$3,500.00 RECOM. CONTROL POINT DOOR HERE
			PROJECT MANAGEMENT			\$ 1,250.00	
						<b>\$52,434.00</b>	<< TOTAL INCLUDES NEW #11 DOOR



LITTLE PAGE DINING HALL

Building	Door #	Type	Door Package Type	Reader Style	CCTV ready	Budget \$	Notes:
Littlepage		BDF	BDF PACKAGE			\$ 2,900.00	
	1	CA	STANDARD STRIKE PACKAGE	PIN PROX	YES	\$ 2,518.00	
	2	-	N/A	N/A	N/A		may not need elec. control this location
	3	-	N/A	N/A	N/A		may not need elec. control this location
	4	FA	FULLY ALARMED - EXIT ONLY	N/A	NO	\$ 1,507.00	
	5	CA	STANDARD STRIKE PACKAGE	PIN PROX	YES	\$ 2,518.00	ENTRANCE TO GYM AREA.
	6,7	FA	FULLY ALARMED - EXIT ONLY	N/A	NO	\$ 1,700.00	HRS ADDED FOR LABOR WIRE, TO
	8	FA	FULLY ALARMED - EXIT ONLY	N/A	NO	\$ 1,507.00	SHARE DCD AND HORN.
				PROJECT MANAGEMENT		\$ 950.00	
					<b>\$ 13,600.00</b>		

ONEIDA HALL

Building	Door #	Type	Door Package Type	Reader Style	CCTV ready	Budget \$	Notes:
Oneida		BDF	BDF PACKAGE			\$ 2,900.00	
	1	CA	APARTMENT PACKAGE	PROX	NO	\$ 2,066.00	MORTISE LOCK, 652 STRIKE
	2	FA	SURFACE VERTIACL ROD 3	N/A	NO	\$ 6,658.00	REPLACE CURRENT PHI SVR
	3	FA	SURFACE VERTICAL ROD 3	N/A	YES	\$ 6,658.00	REPLACE CURRENT PHI SVR
	4	CA	SURFACE VERTICAL ROD 1	PIN PROX	NO	\$ 7,740.00	REPLACE CURRENT PHI SVR
	5	CA	SURFACE VERTICAL ROD 2	PIN PROX	NO	\$ 6,567.00	REPLACE CURRENT PHI SVR
	6	FA	SURFACE VERTICAL ROD 4	N/A	NO	\$ 6,237.00	REPLACE CURRENT PHI SVR
	7	FA	SURFACE VERTICAL ROD 4	N/A	NO	\$ 6,237.00	REPLACE CURRENT PHI SVR
	8	CA	APARTMENT PACKAGE	PROX	NO	\$ 2,066.00	MORTISE LOCK, 652 STRIKE
	9	FA	FULLY ALARMED - EXIT ONLY	N/A	NO	\$ 1,507.00	
	10	CA	STANDARD STRIKE PACKAGE	PIN PROX	YES	\$ 2,518.00	getting new door/frame by campus2004
	11	CA	TUNNEL DBL. DR PACKAGE	PIN PROX	YES	\$ 4,841.00	TOP-SVR X MORTISE EXIT.
	12	CA	STANDARD STRIKE PACKAGE	PIN PROX	YES	\$ 2,518.00	getting new door/frame by campus2004
	13	CA	STANDARD STRIKE PACKAGE	PIN PROX	YES	\$ 2,518.00	getting new door/frame by campus2004
	14	CA	STANDARD STRIKE PACKAGE	PIN PROX	YES	\$ 2,518.00	getting new door/frame by campus2004
15	CO	DOOR CONTACT PACKAGE	N/A	NO	\$ 494.00		
			PROJECT MANAGEMENT		\$ 1,450.00		
					<b>\$ 65,493.00</b>		

SCALES HALL

Building	Door #	Type	Door Package Type	Reader Style	CCTV ready	Budget \$	Notes:
Scales		BDF	BDF PACKAGE			\$ 2,900.00	
	1	CA	APARTMENT PACKAGE	PROX	NO	\$ 2,066.00	MORTISE, 652
	2	CA	SURFACE VERTICAL ROD-1	PIN PROX	YES	\$ 7,740.00	REPLACE PHI SVR DEVICES
	3	CA	SURFACE VERTICAL ROD-2	PIN PROX	NO	\$ 6,567.00	REPLACE PHI SVR DEVICES
	4	DC	DOOR CONTACT ONLY (2)	N/A	NO	\$ 494.00	TIE INTO CLOSEST DCD
	5	CA	STANDARD STRIKE PACKAGE	PIN PROX	YES	\$ 2,518.00	RIM EXIT DEVICE
	6	FA	FULLY ALARMED - EXIT ONLY	N/A	NO	\$ 1,507.00	RIM EXIT DEVICE
	7	CA	STANDARD STRIKE PACKAGE	PIN PROX	YES	\$ 2,518.00	RIM EXIT DEVICE
	8	FA	FULLY ALARMED - EXIT ONLY	N/A	NO	\$ 1,507.00	OUTSIDE PAIR OF DR'S ONLY
			PROJECT MANAGEMENT			\$ 950.00	
						<b><u>\$ 28,767.00</u></b>	

WATERBURY HALL

Building	Door #	Type	Door Package Type	Reader Style	CCTV ready	Budget \$	Notes:
Waterbury		BDF	BDF PACKAGE			\$ 2,900.00	
	1	CA	APARTMENT PACKAGE	PROX	NO	\$ 2,066.00	MORTISE, 652
	2	CA	SURFACE VERTICAL ROD-1	PIN PROX	YES	\$ 7,740.00	NO LOCK HARDWARE ON DR NOW.
	3	CA	SURFACE VERTICAL ROD-2	PIN PROX	NO	\$ 6,567.00	REPLCAE PHI SVR DEVICES
	4	CA	TUNNEL DBL.DR PACKAGE	PIN PROX	YES	\$ 4,841.00	ADD STRIKE TO EXIT BAR SETUP
	5	CA	STANDARD STRIKE PACKAGE	PIN PROX	YES	\$ 2,518.00	RIM EXIT DEVICE
	6	FA	FULLY ALARMED - EXIT ONLY	N/A	NO	\$ 1,507.00	RIM EXIT DEVICE
	8	CA	STANDARD STRIKE PACKAGE	PIN PROX	YES	\$ 2,518.00	RIM EXIT DEVICE
	7	FA	FULLY ALARMED - EXIT ONLY	N/A	NO	\$ 1,507.00	
9	FA	FULLY ALARMED - EXIT ONLY	N/A	NO	\$ 1,507.00		
			PROJECT MANAGEMENT			\$ 950.00	
						<b><u>\$ 34,621.00</u></b>	

JOHNSON HALL

Building	Door #	Type	Door Package Type	Reader Style	CCTV ready	Budget \$	Notes:
Johnson	1	CA	SURFACE VERTICAL ROD-2	PIN PROX	N/A	\$ 6,567.00	USE EXISTING P.S. IN MAIL ROOM PHI, ALREADY, GEN. FOR 110VAC
	2	CA	SURFACE VERTICAL ROD-1	PIN PROX	YES	\$ 7,740.00	\$3,500.00 RECOM. CONTROL POINT DOOR HERE
	3	CA *	DOOR ON EXISTING SYSTEM PROJECT MANAGEMENT	PIN PROX	EXIST.	- \$ 250.00	
						<b>\$ 18,057.00</b>	<< TOTAL INCLUDES NEW #2 DOOR

\* Only one door panel of pair has electric hardware.  
The other panel is manually locked/unlocked.

HART HALL

HART HALL - INTERIOR ACCESS CONVERSION PROJECT

<u>FLOOR #</u>	<u>DR #</u>	<u>TYPE</u>	<u>Door Package Type</u>		<u>CCTV</u>	<u>Budget \$</u>	<u>Notes:</u>
1ST FLOOR	123	CA	HART HALL PACKAGE	PROX	N/A	\$ 1,750.00	INSIDE DOOR PACKGE
	119	CA	HART HALL PACKAGE	PROX	N/A	\$ 1,750.00	INSIDE DOOR PACKGE
2ND FLOOR	205	CA	HART HALL PACKAGE	PROX	N/A	\$ 1,750.00	INSIDE DOOR PACKGE
	207	CA	HART HALL PACKAGE	PROX	N/A	\$ 1,750.00	INSIDE DOOR PACKGE
	227	CA	HART HALL PACKAGE	PROX	N/A	\$ 1,750.00	INSIDE DOOR PACKGE
3RD FLOOR	256	CA	HART HALL PACKAGE	PROX	N/A	\$ 1,750.00	INSIDE DOOR PACKGE
	305	CA	HART HALL PACKAGE	PROX	N/A	\$ 1,750.00	INSIDE DOOR PACKGE
	307	CA	HART HALL PACKAGE	PROX	N/A	\$ 1,750.00	INSIDE DOOR PACKGE
	327	CA	HART HALL PACKAGE	PROX	N/A	\$ 1,750.00	INSIDE DOOR PACKGE
4TH FLOOR	356	CA	HART HALL PACKAGE	PROX	N/A	\$ 1,750.00	INSIDE DOOR PACKGE
	405	CA	HART HALL PACKAGE	PROX	N/A	\$ 1,750.00	INSIDE DOOR PACKGE
	407	CA	HART HALL PACKAGE	PROX	N/A	\$ 1,750.00	INSIDE DOOR PACKGE
	427	CA	HART HALL PACKAGE	PROX	N/A	\$ 1,750.00	INSIDE DOOR PACKGE
5TH FLOOR	456	CA	HART HALL PACKAGE	PROX	N/A	\$ 1,750.00	INSIDE DOOR PACKGE
	505	CA	HART HALL PACKAGE	PROX	N/A	\$ 1,750.00	INSIDE DOOR PACKGE
	507	CA	HART HALL PACKAGE	PROX	N/A	\$ 1,750.00	INSIDE DOOR PACKGE
6TH FLOOR	527	CA	HART HALL PACKAGE	PROX	N/A	\$ 1,750.00	INSIDE DOOR PACKGE
	556	CA	HART HALL PACKAGE	PROX	N/A	\$ 1,750.00	INSIDE DOOR PACKGE
	605	CA	HART HALL PACKAGE	PROX	N/A	\$ 1,750.00	INSIDE DOOR PACKGE
	607	CA	HART HALL PACKAGE	PROX	N/A	\$ 1,750.00	INSIDE DOOR PACKGE
	627	CA	HART HALL PACKAGE	PROX	N/A	\$ 1,750.00	INSIDE DOOR PACKGE
	656	CA	HART HALL PACKAGE	PROX	N/A	\$ 1,750.00	INSIDE DOOR PACKGE

HART HALL

HART HALL - INTERIOR ACCESS CONVERSION PROJECT

<u>FLOOR #</u>	<u>DR #</u>	<u>TYPE</u>	<u>Door Package Type</u>		<u>CCTV</u>	<u>Budget \$</u>	<u>Notes:</u>
<b>7TH FLOOR</b>	705	CA	HART HALL PACKAGE	PROX	N/A	\$ 1,750.00	INSIDE DOOR PACKGE
	707	CA	HART HALL PACKAGE	PROX	N/A	\$ 1,750.00	INSIDE DOOR PACKGE
	727	CA	HART HALL PACKAGE	PROX	N/A	\$ 1,750.00	INSIDE DOOR PACKGE
	756	CA	HART HALL PACKAGE	PROX	N/A	\$ 1,750.00	INSIDE DOOR PACKGE
<b>8TH FLOOR</b>	805	CA	HART HALL PACKAGE	PROX	N/A	\$ 1,750.00	INSIDE DOOR PACKGE
	807	CA	HART HALL PACKAGE	PROX	N/A	\$ 1,750.00	INSIDE DOOR PACKGE
	827	CA	HART HALL PACKAGE	PROX	N/A	\$ 1,750.00	INSIDE DOOR PACKGE
	856	CA	HART HALL PACKAGE	PROX	N/A	\$ 1,750.00	INSIDE DOOR PACKGE
<b>9TH FLOOR</b>	905	CA	HART HALL PACKAGE	PROX	N/A	\$ 1,750.00	INSIDE DOOR PACKGE
	907	CA	HART HALL PACKAGE	PROX	N/A	\$ 1,750.00	INSIDE DOOR PACKGE
	927	CA	HART HALL PACKAGE	PROX	N/A	\$ 1,750.00	INSIDE DOOR PACKGE
	956	CA	HART HALL PACKAGE	PROX	N/A	\$ 1,750.00	INSIDE DOOR PACKGE
			PROJECT MANAGEMENT			\$ 1,450.00	
						<b><u>\$ 60,950.00</u></b>	

Cost is based on existing lock hardware being used and a new proximity reader being installed on the door frame. This means that new lock does not need to be purchased and a custom plate does not need to be installed on the door to cover mounting holes. The existing lock card swipe on the door will still be there but disabled. A plan could be made to visually conceal the old card reader. To install new locks and plate would cost approx. \$ 350.00 per door.

## Available Electric Power

Information provided by the Oswego State Electric Dept.  
April 27, 2004

### Card Access AC Power Source Information

Building	Description of Doors on 24 Hour DC backup (Electrified Hardware)	Location of AC Source Branch Panel (All Access Power)	Branch Panel ID	Branch Panel Breaker Avail.	Generator Power Avail.	Branch Breaker Type
Cayuga	Front and Back doors	Electric Room	LP-ST	YES	YES	GE
Funnelle	Front(E), Side(N) and Back(W)	Electric Room	EM	YES	YES	Westinghouse
Hart	NA	Electric Room	LP-EM2	YES	YES	Square D
Lonis	NA				YES	
Mackin	NA				?	
Moreland	NA				?	
Oneida	Front Doors	Electric Room	ST	YES	YES	Square D
Onondaga	Front Doors	Electric Room	LP-S&E	YES	YES	Square D
Seneca	Front Doors	Electric Room	LP-S&E	YES	YES	Westinghouse
Scales	Front Doors	Electric Room	EP-1	YES	YES	Square D
Waterbury	Front Doors	outside Electric Room	EP-1	YES	YES	Square D
Pathfinder	Tunnel	Electric Room	LP-S&E	YES	NO	GE
Littlepage	Tunnel	Electric Room	LP-S&E	YES	NO	Square D
Cooper	Tunnel	outside Electric Room	LP-E	YES	NO	GE

**Note:**

- Twenty-four hour backup for all front doors as emergency power cannot be guaranteed.
- Standard battery backup for all other doors
- Building controller on building network rack may need further approval from networking department.
- Any use of generator power may only be taken from the above list of electric panels, not by connecting to existing circuits. This applies to power for electrified door hardware (i.e.; vertical rods).

**DOOR HARDWARE PACKAGE TYPES**

<u>PACKAGE TYPE</u>	<u>ITEM QTY</u>	<u>PART NUMBER</u>	<u>ITEM DESCRIPTION</u>	<u>PRICE EACH</u>	<u>EXTENDED \$</u>
BDF PACKAGE	1	051-507972	SITE ETHERNET INTERFACE	\$ 325.00	\$ 325.00
	1	149-101117	SITE CONTROL UNIT	\$ 310.00	\$ 310.00
Building	2	PS1-100212-001	P.S. W/8AH BATTERY/LINE CONDI.	\$ 354.00	\$ 708.00
Distribution	1	041-100992	SURFACE BOX W/LOCK	\$ 32.00	\$ 32.00
Frame	1	CABLE/MISC	MOUNT ITEMS / CABLE CONN.	\$ 125.00	\$ 125.00
	1	INSTALL/PROGRAM	LABOR TO TEST PROGRAM	\$ 850.00	\$ 850.00
	1	110VAC HOOK UP	ELECTRIC LABOR. WIRE, CONDUIT.	\$ 550.00	\$ 550.00
					<u>\$ 2,900.00</u>

- \*\* 110VAC WIRING AND CONDUIT IS INCLUDED IN THIS REPORT.
  - \*\* ROOM IN ELECTRIC/DATA CLOSET FOR PANELS IS ASSUMED. (3' X 3' AREA)
  - \*\* STATIC IP ADDRESS FOR EACH BUILDING PROVIDED BY COLLEGE.
  - \*\* ACCESS TO BUILDING DURING NORMAL WORKING HOURS (8AM-5PM, M-F, LESS HOLIDAY'S)
  - \*\* PIN PROX READERS WILL BE INSTALLED ON OUTSIDE DOORS. (GRAY) KP-6840.
  - \*\* MULLION STYLE PROX READER ON INSIDE ACCESS POINTS ( GRAY) SR-2400
  - \*\* MILLENIUM POWER SUPPLY TO BE PLUGGED INTO DATA RACK( ALL RACKS HAD ROOM AS OF 4/22/2004)
  - \*\* BATTERY BACK-UP FOR PHI. POWER SUPPLIES ON CARD READER DOORS ONLY, NOT ON AUTO UNLOCK DOORS.
  - \*\*\*\*\*ALL ELECTRIC RATES ARE WITH UNION LABOR FROM CPS OF OSWEGO.\*\*\*\*\*
  - \*\*\*\*\*ALL ACCESS LABOR IS NON-UNION LABOR AT NON-UNION RATES.\*\*\*\*\*
- (Based on MAC Systems labor rate of \$70/hour, which Mac systems thinks would cover the associated prevailing wage rates for Oswego.)

PACKAGE TYPE  
APARTMENT PACKAGE  
(SINGLE DOOR)

<u>QTY</u>	<u>PART NUMBER</u>	<u>DESCRIPTION</u>	<u>PRICE</u>
1	642 - 652	FOLGER ADAM 12VDC STIKE	\$ 290.00
1	DS-160	REX AND HORN UNIT 12VDC	\$ 125.00
1	SR-2400	AWID MULLION PROX READER	\$ 108.00
1	SR-1078CW	DOOR CONTACT-KIT 3/4	\$ 19.00
1	WIRE/CABLE	WIRE CABLE, BRACKET	\$ 150.00
1	MISC	CONDUIT/WIRE MOLD/ETC.	\$ 125.00
1	P & T	PROGRAM AND TEST	\$ 75.00
1	INSTALL LABOR	LABOR TO INSTALL ABOVE	\$ 850.00
1	149-100958	DOOR CONTROL DEVICE	\$ 292.00
1	041-100992	SURFACE BOX W/LOCK 1 DCD	\$ 32.00
			<u>\$ 2,066.00</u>

STANDARD STRIKE PACKAGE  
(SINGLE DOOR)

<u>QTY</u>	<u>PART NUMBER</u>	<u>DESCRIPTION</u>	<u>PRICE</u>
1	652, 310, 9600	12VDC ELECTRIC STRIKE	\$ 290.00
1	DS-160	REX AND HORN UNIT 12VDC	\$ 125.00
1	KP-6840	AWID PIN/PRIX WALL SWITCH	\$ 225.00
1	SR-1078CW	DOOR CONTACT-KIT 3/4	\$ 19.00
1	WIRE/CABLE	WIRE CABLE, BRACKET	\$ 150.00
1	MISC	CONDUIT/WIRE MOLD/ETC.	\$ 150.00
1	P & T	PROGRAM AND TEST	\$ 75.00
1	CCTV-150	RG 59/18 2,BOX AND BNC'S	\$ 210.00
1	INSTALL LABOR	LABOR TO INSTALL ABOVE	\$ 950.00
1	149-100958	DOOR CONTROL DEVICE	\$ 292.00
1	041-100992	SURFACE BOX W/LOCK 1 DCD	\$ 32.00
			<u>\$ 2,518.00</u>

DOUBLE DOOR STRIKE PACKAGE

<u>QTY</u>	<u>PART NUMBER</u>	<u>DESCRIPTION</u>	<u>PRICE</u>
1	310-2 2/3 OB	12VDC ELECTRIC STRIKE	\$ 325.00
1	DS-160	REX AND HORN UNIT 12VDC	\$ 125.00
1	KP-6840	AWID PIN/PRIX WALL SWITCH	\$ 225.00
2	SR-1078CW	DOOR CONTACT-KIT 3/4	\$ 38.00
1	WIRE/CABLE	WIRE CABLE, BRACKET	\$ 150.00
1	MISC	CONDUIT/WIRE MOLD/ETC.	\$ 150.00
1	P & T	PROGRAM AND TEST	\$ 75.00
1	CCTV-150	RG 59/18 2,BOX AND BNC'S	\$ 210.00
1	INSTALL LABOR	LABOR TO INSTALL ABOVE	\$ 1,250.00
1	MARRY/HAGER	WIRED HINGE	\$310.00
1	149-100958	DOOR CONTROL DEVICE	\$ 292.00
1	041-100992	SURFACE BOX W/LOCK 1 DCD	\$ 32.00
			<u>\$ 3,182.00</u>



**MAG-LOCK DOOR PACKAGE**

<u>QTY</u>	<u>PART NUMBER</u>	<u>DESCRIPTION</u>	<u>PRICE</u>
2	3000 SERIES	12VDC DYNALOCK MAG US28	\$ 390.00
1	DS-160	REX AND HORN UNIT 12VDC	\$ 125.00
1	KP-6840	AWID PIN/PRIX WALL SWITCH	\$ 225.00
2	SR-1078CW	DOOR CONTACT-KIT 3/4	\$ 19.00
1	WIRE/CABLE	WIRE CABLE, BRACKET	\$ 150.00
1	MISC	CONDUIT/WIRE MOLD/ETC.	\$ 150.00
1	CCTV-150	RG 59/18 2,BOX AND BNC'S	\$ 210.00
1	P & T	PROGRAM AND TEST	\$ 75.00
1	INSTALL LABOR	LABOR TO INSTALL ABOVE	\$ 1,357.00
1	149-100958	DOOR CONTROL DEVICE	\$ 292.00
1	041-100992	SURFACE BOX W/LOCK 1 DCD	\$ 32.00
1	BUTTON/WIRE/LABOR	EMG BUTTON/FIRE TIE IN KIT	\$ 350.00
			<b>\$ 3,375.00</b>

**SURFACE VERTICAL ROD-1**  
**ELECTRIC LATCH RETRACTION**  
**WITH REX, FOR 1 DOUBLE DOOR.**  
**SVR-1, 125' DISTANCE MAX.**  
**WITH # 12 WIRE**

<u>QTY</u>	<u>PART NUMBER</u>	<u>DESCRIPTION</u>	<u>PRICE</u>
2	TSELR22031703US32D	SVR EXIT DEVICE W REX.ELR	\$ 2,460.00
2	SL-1101-HD 10 WIRE	SELECT CON'T. HINGE 10 WIRE	\$ 650.00
1	KP-6840	AWID PIN/PRIX WALL SWITCH	\$ 225.00
2	SR-1078CW	DOOR CONTACT-KIT 3/4	\$ 38.00
2	WIRE/CABLE	WIRE CABLE, BRACKET	\$ 300.00
1	ELR-152	POWER SUPPLY, FOR 2 BARS	\$ 536.00
1	BT 150-07	BATTERY BACKUP CARD	\$ 282.00
1	BATTERY KIT	3 18AH, CABLES, BOX, COVER	\$ 225.00
2	MISC	CONDUIT/WIRE MOLD/ETC.	\$ 300.00
1	CCTV-150	RG 59/18 2,BOX AND BNC'S	\$ 210.00
2	P & T	PROGRAM AND TEST	\$ 150.00
1	INSTALL LABOR	LABOR TO INSTALL ABOVE	\$ 2,040.00
1	149-100958	DOOR CONTROL DEVICE	\$ 292.00
1	041-100992	SURFACE BOX W/LOCK 1 DCD	\$ 32.00
			<b>\$ 7,740.00</b>

**SURFACE VERTICAL ROD-2**  
**ELECTRIC LATCH RETRACTION**  
**WITH REX, FOR 1 DOUBLE DOOR,**  
**TO BE RUN OFF P.S. FROM PKG 1**  
**\*\*SVR-2, 125' MAX DISTANCE\*\***  
**WITH # 12 WIRE**

<u>QTY</u>	<u>PART NUMBER</u>	<u>DESCRIPTION</u>	<u>PRICE</u>
2	TSELR22031703US32D	SVR EXIT DEVICE W REX.ELR	\$ 2,460.00
2	SL-1101-HD 10 WIRE	SELECT CON'T. HINGE 10 WIRE	\$ 650.00
1	KP-6840	AWID PIN/PRIX WALL SWITCH	\$ 225.00
2	SR-1078CW	DOOR CONTACT-KIT 3/4	\$ 38.00
2	WIRE/CABLE	WIRE CABLE, BRACKET	\$ 300.00
2	CM-150-08	CONTROL MOD. 1 DEVICE	\$ 290.00
2	MISC	CONDUIT/WIRE MOLD/ETC.	\$ 300.00
2	P & T	PROGRAM AND TEST	\$ 150.00

1	INSTALL LABOR	LABOR TO INSTALL ABOVE	\$	1,830.00
1	149-100958	DOOR CONTROL DEVICE	\$	292.00
1	041-100992	SURFACE BOX W/LOCK 1 DCD	\$	32.00
			\$	<u>6,567.00</u>

**SURFACE VERTICAL ROD-3**  
**ELECTRIC LATCH RETRACTION**  
**WITH REX, AUTO UNLOCK ONLY**  
**ELR-152 POWER SUPPLY**  
**\*\*SVR-3, 125' DISTANCE MAX.\*\***  
**WITH # 12 WIRE**

<u>QTY</u>	<u>PART NUMBER</u>	<u>DESCRIPTION</u>		<u>PRICE</u>
2	TSELR22031703US32D	SVR EXIT DEVICE W REX.ELR	\$	2,460.00
2	SL-1101-HD 10 WIRE	SELECT CON'T. HINGE 10 WIRE	\$	650.00
		<b>0 NO READER, AUTO LOCK AND UNLOCK ONLY</b>	\$	-
2	SR-1078CW	DOOR CONTACT-KIT 3/4	\$	38.00
1	ELR-152	POWER SUPPLY, FOR 2 BARS	\$	536.00
2	WIRE/CABLE	WIRE CABLE, BRACKET	\$	275.00
2	MISC	CONDUIT/WIRE MOLD/ETC.	\$	300.00
2	P & T	PROGRAM AND TEST	\$	150.00
1	INSTALL LABOR	LABOR TO INSTALL ABOVE	\$	1,925.00
1	149-100958	DOOR CONTROL DEVICE	\$	292.00
1	041-100992	SURFACE BOX W/LOCK 1 DCD	\$	32.00
			\$	<u>6,658.00</u>

**SURFACE VERTICAL ROD-4**  
**ELECTRIC LATCH RETRACTION**  
**WITH REX, AUTO UNLOCK ONLY**  
**TO BE RUN OFF P.S. FROM PKG 3**  
**SVR-4, 125' DISTANCE MAX.**  
**WITH # 12 WIRE**

<u>QTY</u>	<u>PART NUMBER</u>	<u>DESCRIPTION</u>		<u>PRICE</u>
2	TSELR22031703US32D	SVR EXIT DEVICE W REX.ELR	\$	2,460.00
2	SL-1101-HD 10 WIRE	SELECT CON'T. HINGE 10 WIRE	\$	650.00
		<b>0 NO READER, AUTO LOCK AND UNLOCK ONLY</b>	\$	-
2	SR-1078CW	DOOR CONTACT-KIT 3/4	\$	38.00
2	CM-150-08	CONTROL MOD. 1 DEVICE	\$	290.00
2	WIRE/CABLE	WIRE CABLE, BRACKET	\$	275.00
2	MISC	CONDUIT/WIRE MOLD/ETC.	\$	300.00
2	P & T	PROGRAM AND TEST	\$	150.00
1	INSTALL LABOR	LABOR TO INSTALL ABOVE	\$	1,750.00
1	149-100958	DOOR CONTROL DEVICE	\$	292.00
1	041-100992	SURFACE BOX W/LOCK 1 DCD	\$	32.00
			\$	<u>6,237.00</u>

**TUNNEL DBL. DOORS PACKAGE**  
**SVR- 125' DISTANCE MAX.**  
**WITH # 12 WIRE**

<u>QTY</u>	<u>PART NUMBER</u>	<u>DESCRIPTION</u>		<u>PRICE</u>
1	ELR22031703US32D	SVR EXIT DEVICE ELR ONLY	\$	1,196.00
1	6 WIRE HINGE	6 WIRE HINGE, US32D	\$	250.00
1	KP-6840	AWID PIN/PRIX WALL SWITCH	\$	225.00
2	SR-1078CW	DOOR CONTACT-KIT 3/4	\$	38.00
1	WIRE/CABLE	WIRE CABLE, BRACKET	\$	150.00
1	ELR-151	PHI P.S. WITH 1 CARD	\$	386.00
1	BT 150-07	BATTERY BACKUP CARD	\$	282.00
1	BATTERY KIT	3 18AH, CABLES, BOX, COVER	\$	225.00

1 MISC	CONDUIT/WIRE MOLD/ETC.	\$	150.00
1 P & T	PROGRAM AND TEST	\$	150.00
1 INSTALL LABOR	LABOR TO INSTALL ABOVE	\$	1,340.00
1 DS-160	REX AND HORN UNIT 12VDC	\$	125.00
1 149-100958	DOOR CONTROL DEVICE	\$	292.00
1 041-100992	SURFACE BOX W/LOCK 1 DCD	\$	32.00

\$ 4,841.00

<u>FULLY ALARMED PACKAGE</u>	<u>QTY</u>	<u>PART NUMBER</u>	<u>DESCRIPTION</u>	<u>PRICE</u>
	1	149-100958	DOOR CONTROL DEVICE	\$ 292.00
	1	041-100992	SURFACE BOX W/LOCK 1 DCD	\$ 32.00
	1	DS-160	REX AND HORN UNIT 12VDC	\$ 125.00
	2	SR-1078CW	DOOR CONTACT-KIT 3/4	\$ 38.00
	1	WIRE/CABLE	WIRE CABLE, BRACKET	\$ 150.00
	1	INSTALL LABOR	LABOR TO INSTALL ABOVE	\$ 720.00
	1	MISC	CONDUIT/WIRE MOLD/ETC.	\$ 150.00
				\$ <u>1,507.00</u>

<u>DOOR CONTACT ONLY PACKAGE</u>	<u>QTY</u>	<u>PART NUMBER</u>	<u>DESCRIPTION</u>	<u>PRICE</u>
	1	SR-1078CW	DOOR CONTACT	\$ 19.00
	1	WIRE CABLE/ PIPE	WIRE AND CONDUIT TO DCD	\$ 150.00
	1	LABOR	WIRE TO CLOSEST DCD	\$ 325.00
				\$ <u>494.00</u>

<u>HART HALL INSIDE DR PACKAGE</u>	<u>QTY</u>	<u>PART NUMBER</u>	<u>DESCRIPTION</u>	<u>PRICE</u>
	1	PS1-100212-001	P.S. W/8AH BATTERY/LINE CONDI.	\$ 50.00
	1	SR-2400	AWID MULLION PROX READER	\$ 108.00
	1	642 - 652	FOLGER ADAM 12VDC STIKE	\$ 290.00
	1	WIRE/CABLE	WIRE CABLE, BRACKET	\$ 95.00
	1	MISC	CONDUIT/WIRE MOLD/ETC.	\$ 50.00
	1	P & T	PROGRAM AND TEST	\$ 73.00
	1	INSTALL LABOR	LABOR TO INSTALL ABOVE	\$ 760.00
	1	149-100958	DOOR CONTROL DEVICE	\$ 292.00
	1	041-100992	SURFACE BOX W/LOCK 1 DCD	\$ 32.00
				\$ <u>1,750.00</u>

**NOTES:**

*1/8 power supply  
STANDALONE 950 LOCKS  
TO REMAIN ON DOOR,.*

# BUILDING ACCESS CONTROL

## STUDY FOR RESIDENCE HALL BUILDINGS AND ADJOINING DINING HALLS

### BUILDINGS SURVEYED

- Lonis Hall
- Mackin Dining Hall
- Moreland Hall
- Funnelle Hall
- Cooper Dining Hall / Cooper Fitness Center
- Hart hall
- Seneca Hall
- Pathfinder Dining Hall
- Cayuga Hall
- Onondaga Hall
- Littlepage Dining Hall / Glimmerglass Fitness Center
- Oneida Hall
- Scales Hall
- Waterbury Hall
- ~~Riggs Hall~~ (under construction)
- ~~Lakeside Dining Hall~~(under construction)
- Johnson Hall

#### Floor Plan Key:

CA = Card Access door

FA = Fully Alarmed door

CO = Contact Only door


FROM  
COOPER

TUNNEL


NOTE!  
DOORS SWING  
WRONG WAY FOR  
ACCESS CONTROL  
TO FUNNEL

NA ⑧

CA ⑨

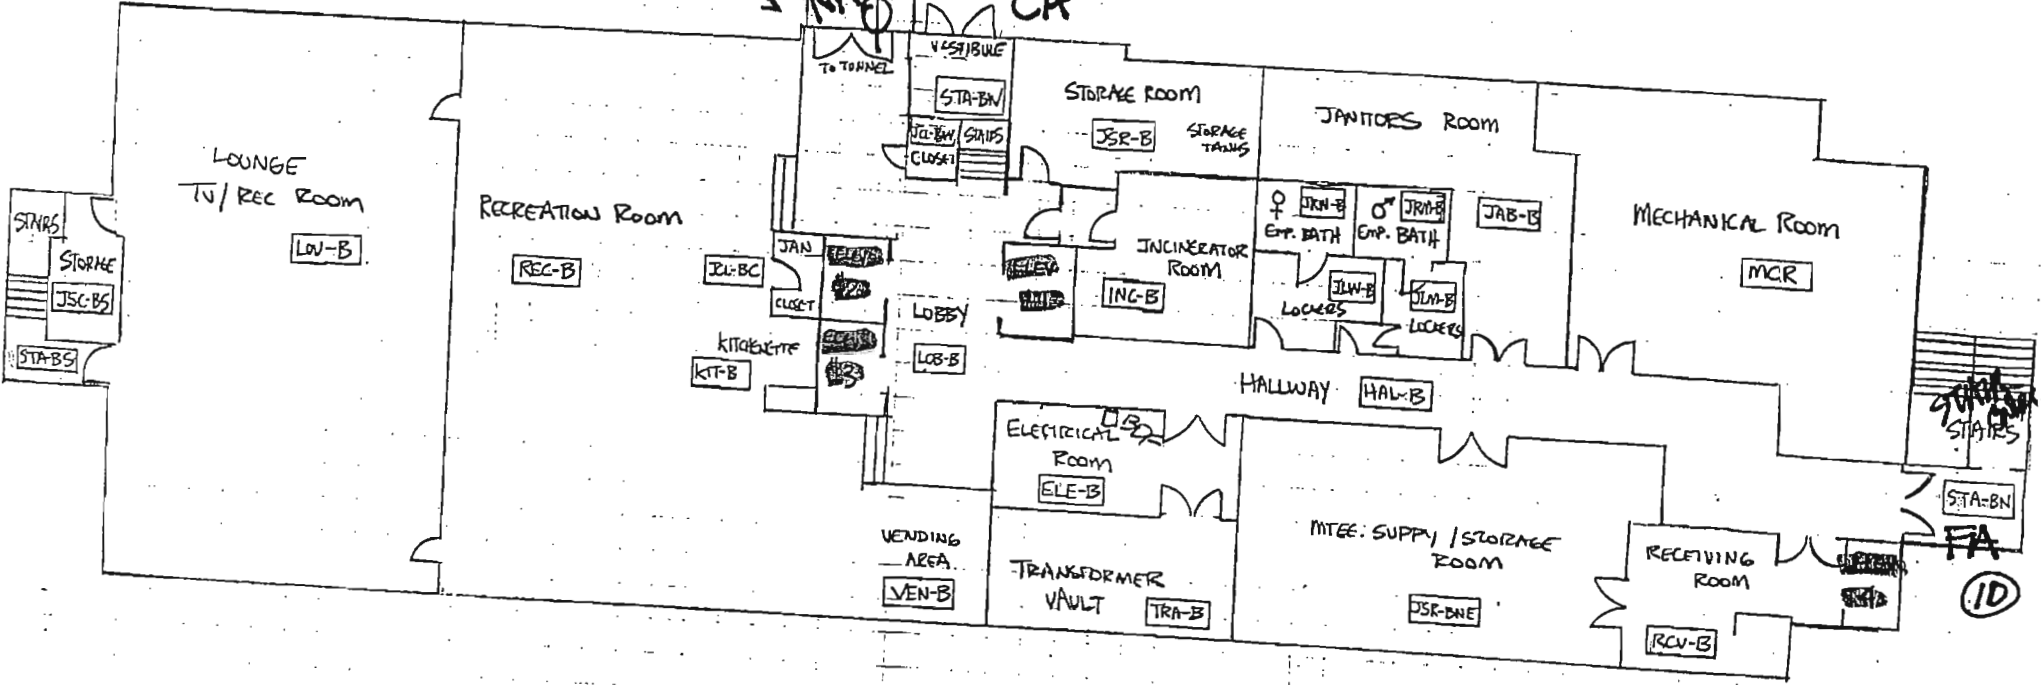

FUNNELLE HALL #48  
BASEMENT

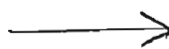



COOPER DINING HALL 1<sup>st</sup> FLOOR

FA ⑥

FA ⑤

COOPER FITNESS CENTER

BATHROOM ♂

NAUTILUS ROOM

102 CP

WEIGHT TRAINING AREA

58'-8" x 39'-9"

~2326 sq. ft.

(area carpeted)

126 CP

AEROBIC AREA

36'-5" x 39'-9"

~1460 sq. ft.

123 CP BATHROOM ♀

WOMEN'S LOCKER AREA

124 CP

TRAINING ROOM

122 CP

①

CA

MARKET

WEST USED WALKWAY

132

HM

A

②

CA

RT

111

①

C.O.

BDF

ELEVATOR PASSENGER

HALLWAY 127 1<sup>st</sup> FLOOR

AM

MECHANICAL SPACE

To DINING HALL

STAIRS UP

DINING HALL STORAGE

139

121 HM

JAN. CLOSET

133 HM EAST TUNNEL TO TUNNEL


Fire Rated

④

NOTE:


DOOR SWING AND FIRE EGRESS QUESTIONS MUST BE DISCUSSED BY CAMRIS.

#11

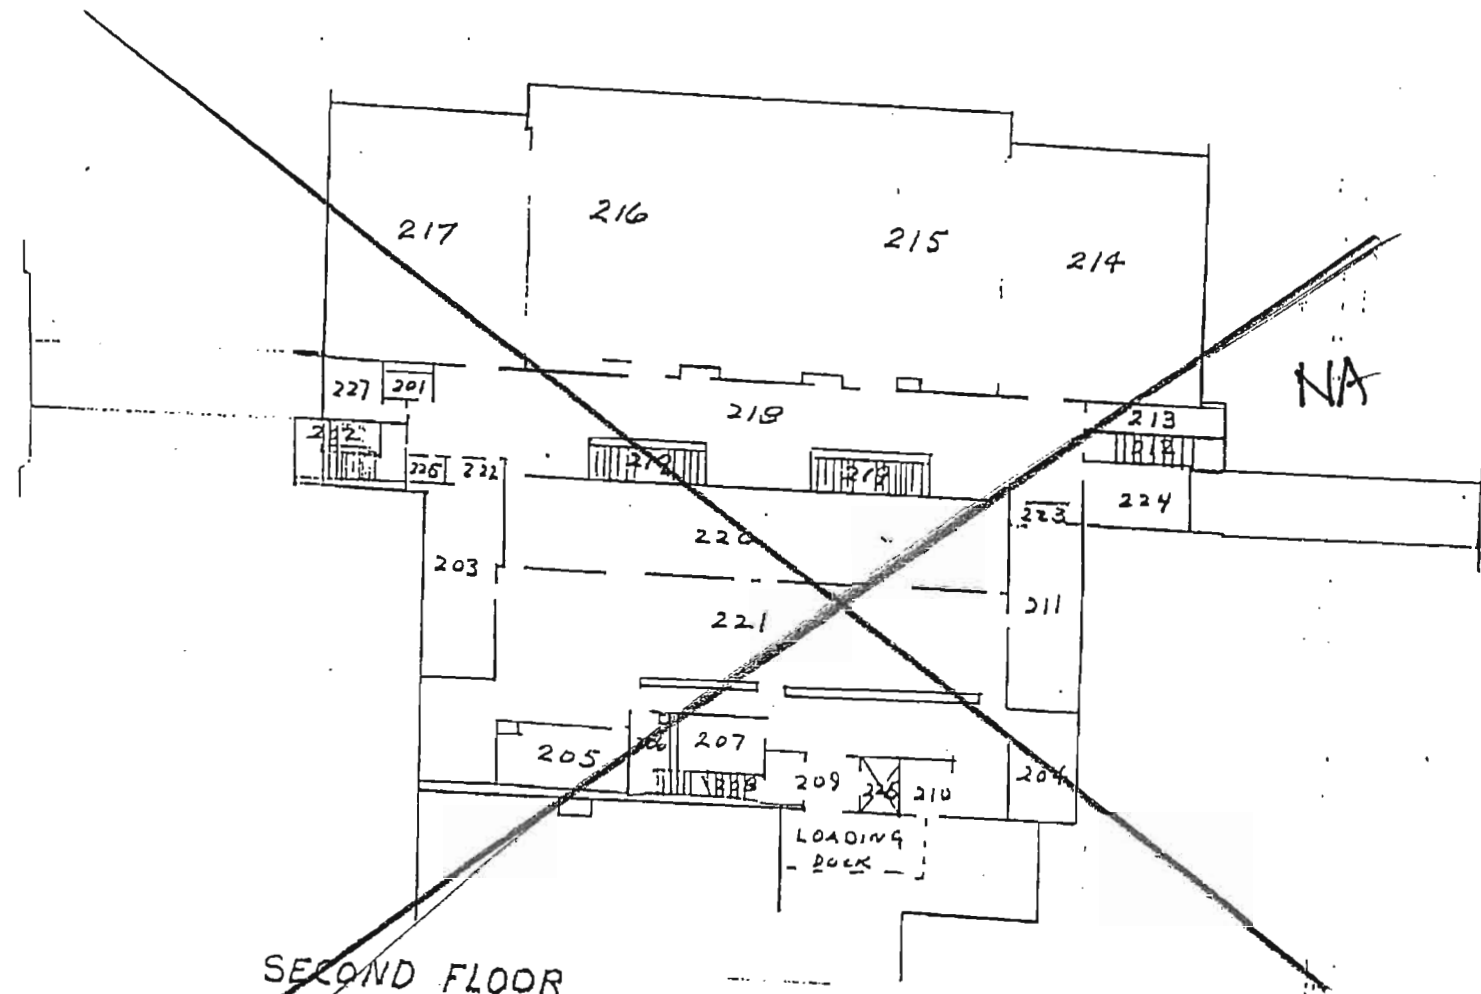


SECOND FLOOR  
 COOPER DINING HALL STAGE VII BLDG #47  
 SUCO


SCALE 1/4" = 1' - 0"

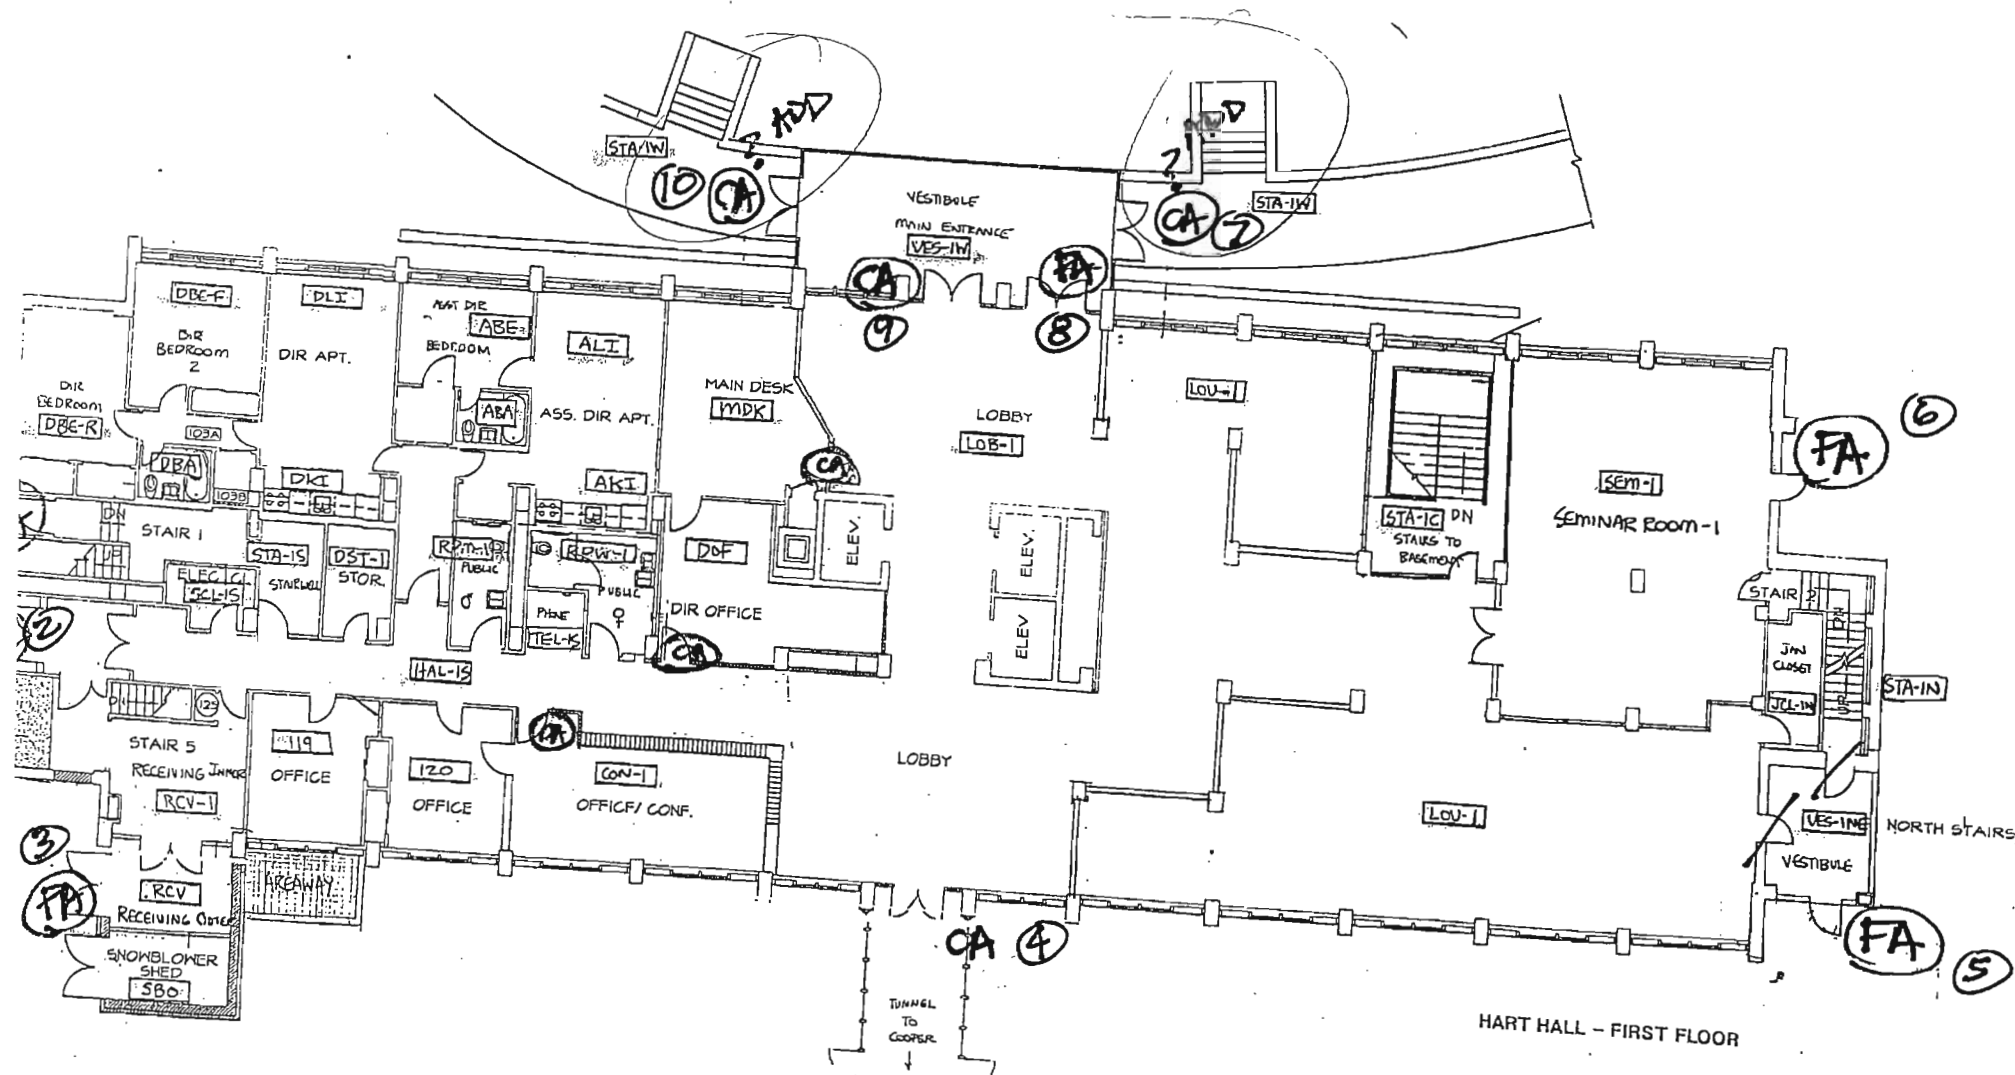



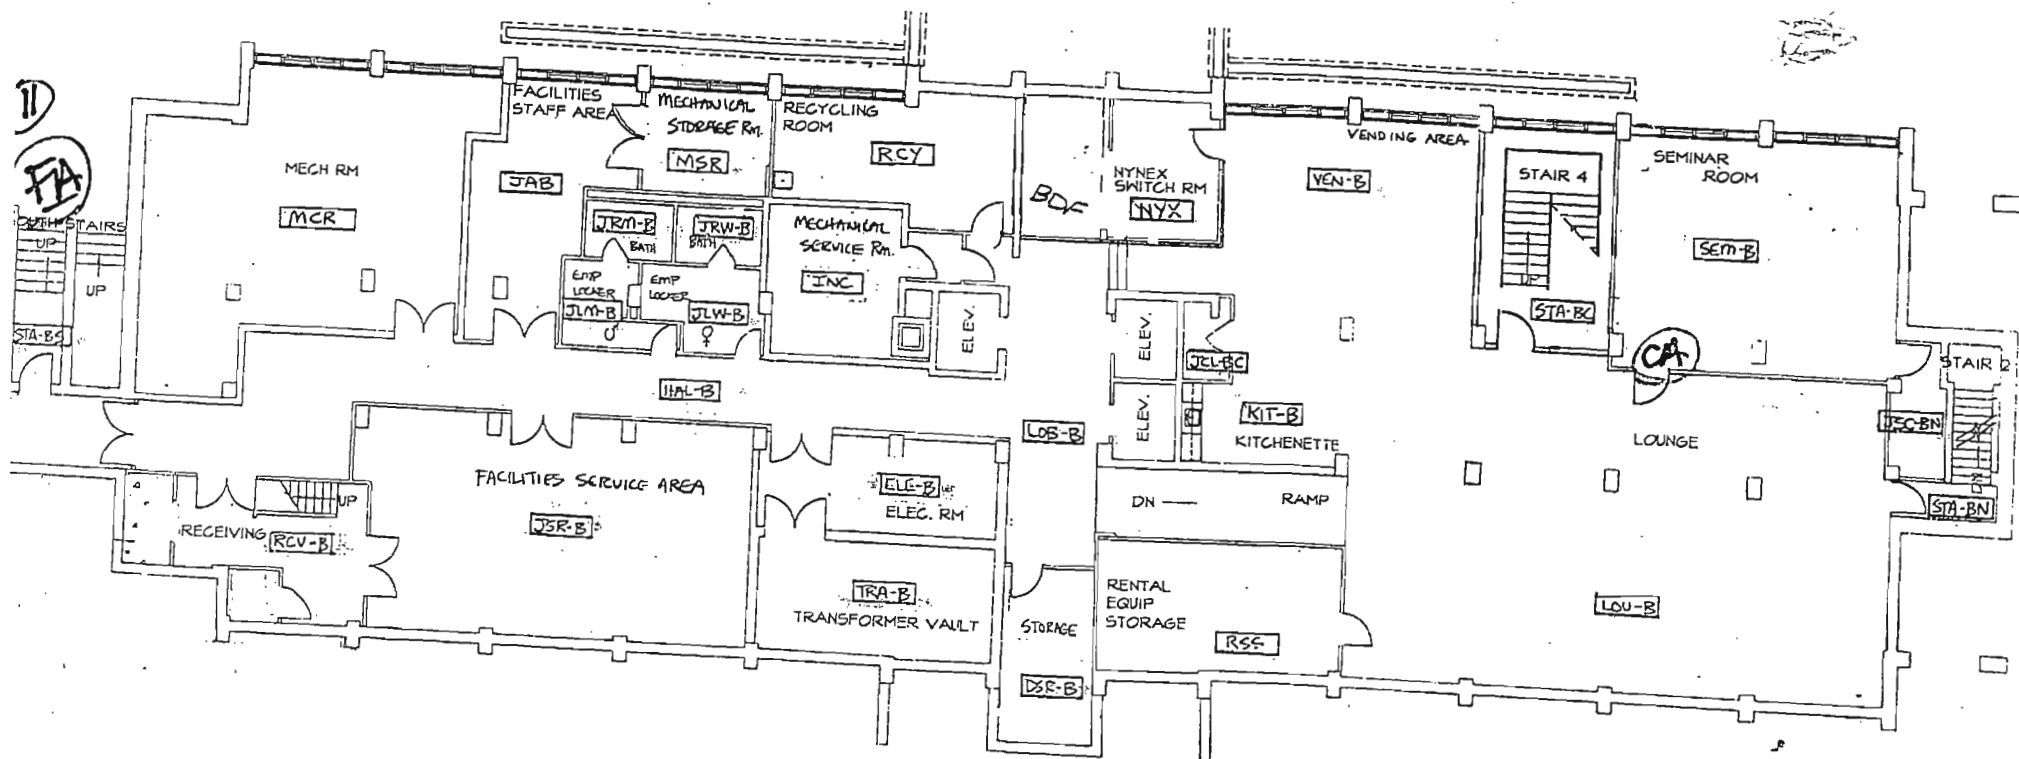

HART HALL - BASEMENT LEVEL

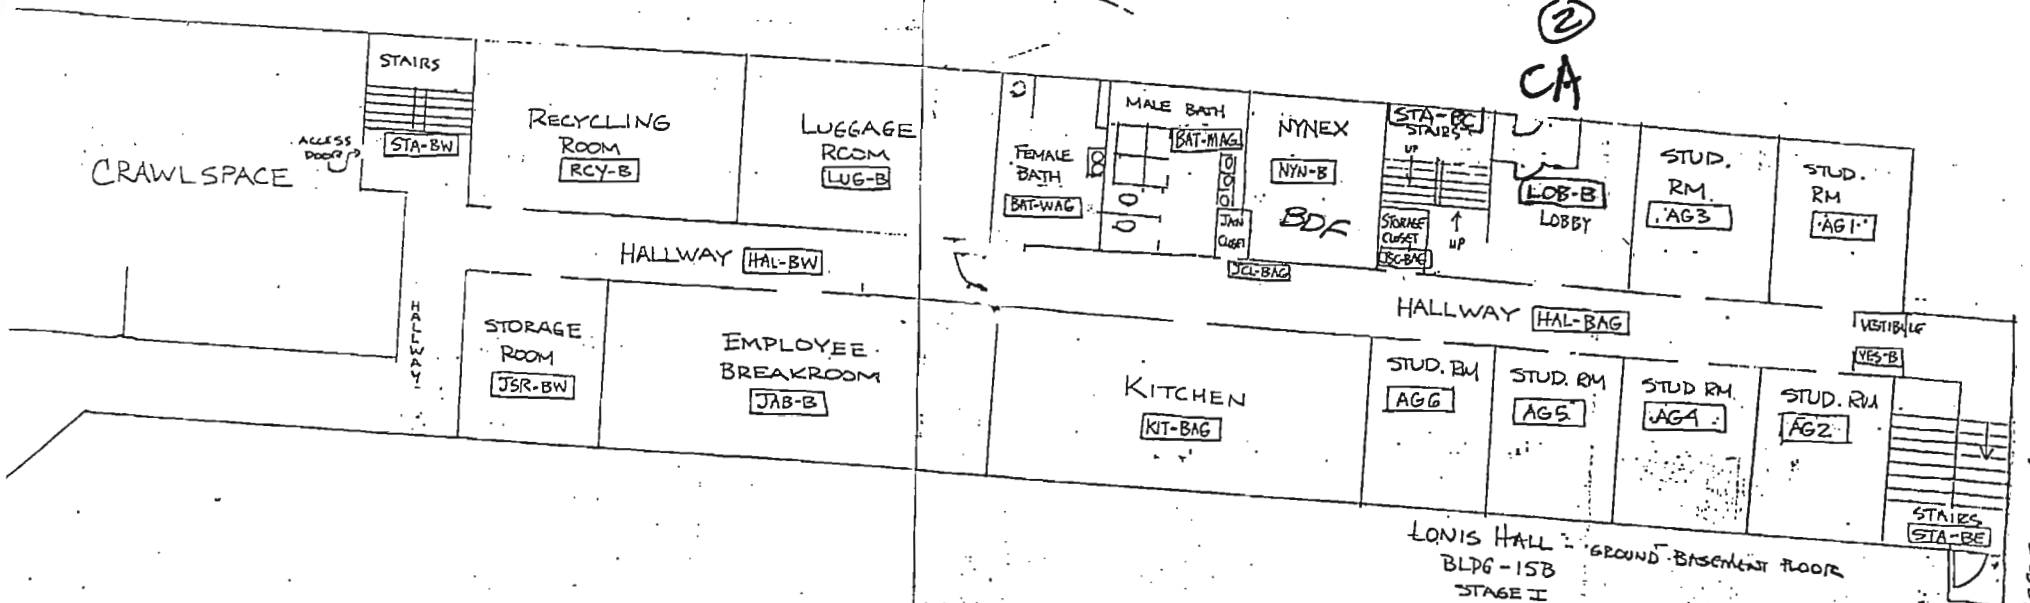


②  
CA

LONIS HALL - GROUND-BASEMENT FLOOR  
BLDG-15B  
STAGE I

LONIS BASEMENT

CA  
①


Street parking

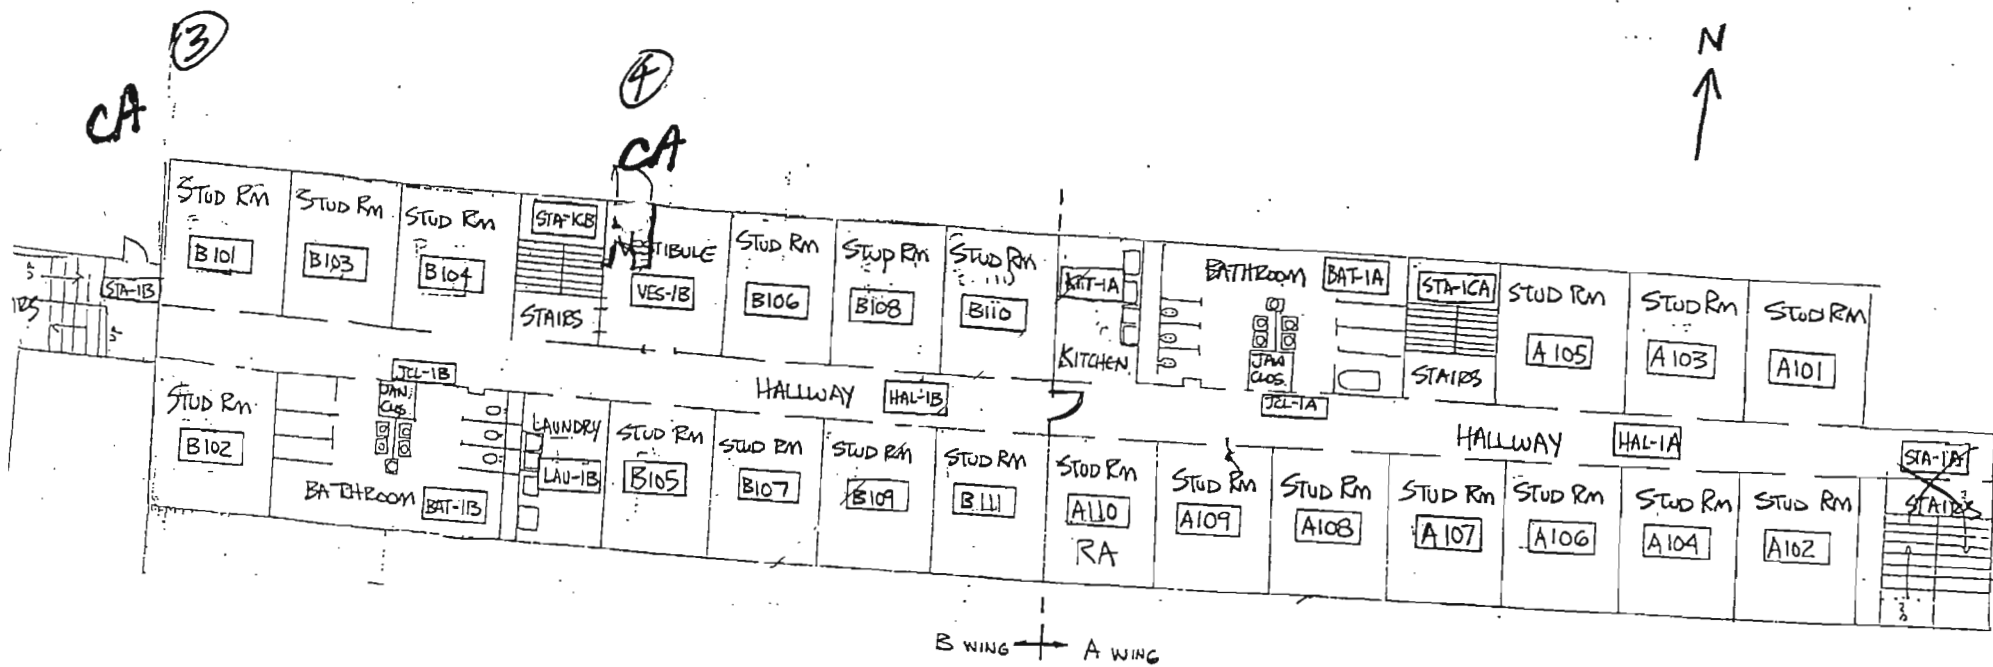

LOUIS HALL 1<sup>ST</sup> FLOOR  
 BUILDING 15B STAGE I




①  
CA

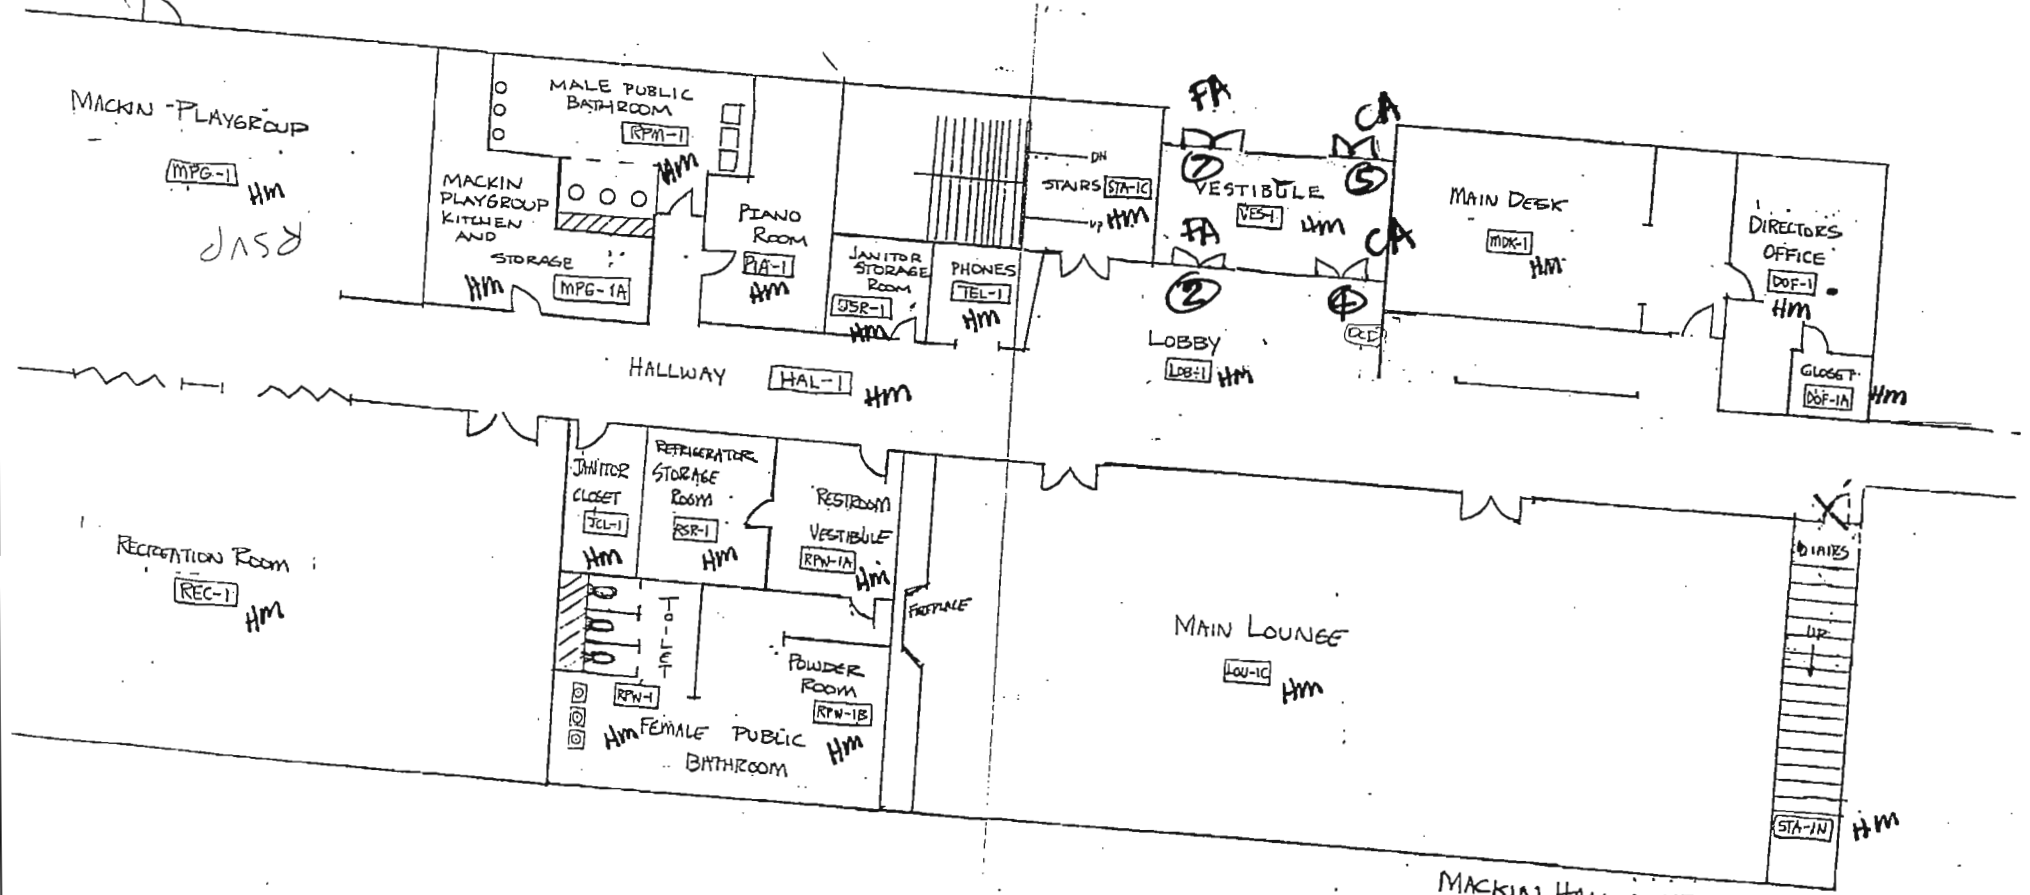


MACKIN HALL = 1ST FLOOR  
BUILDING # 15 STAGE II

MACKIN 1ST FLOOR

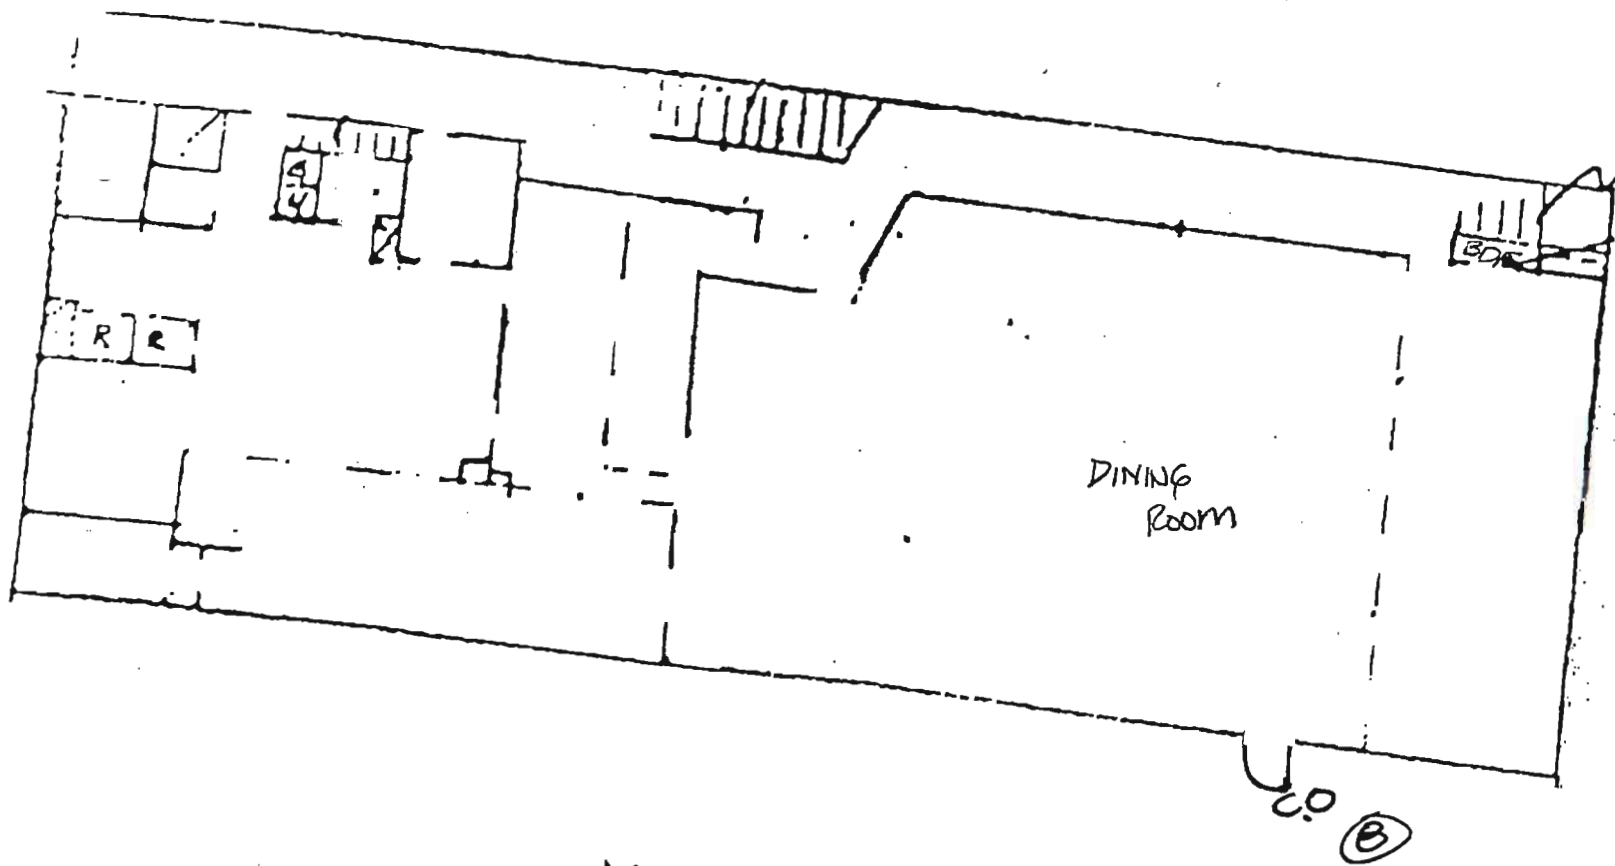


MACKIN  
GROUND FLOOR



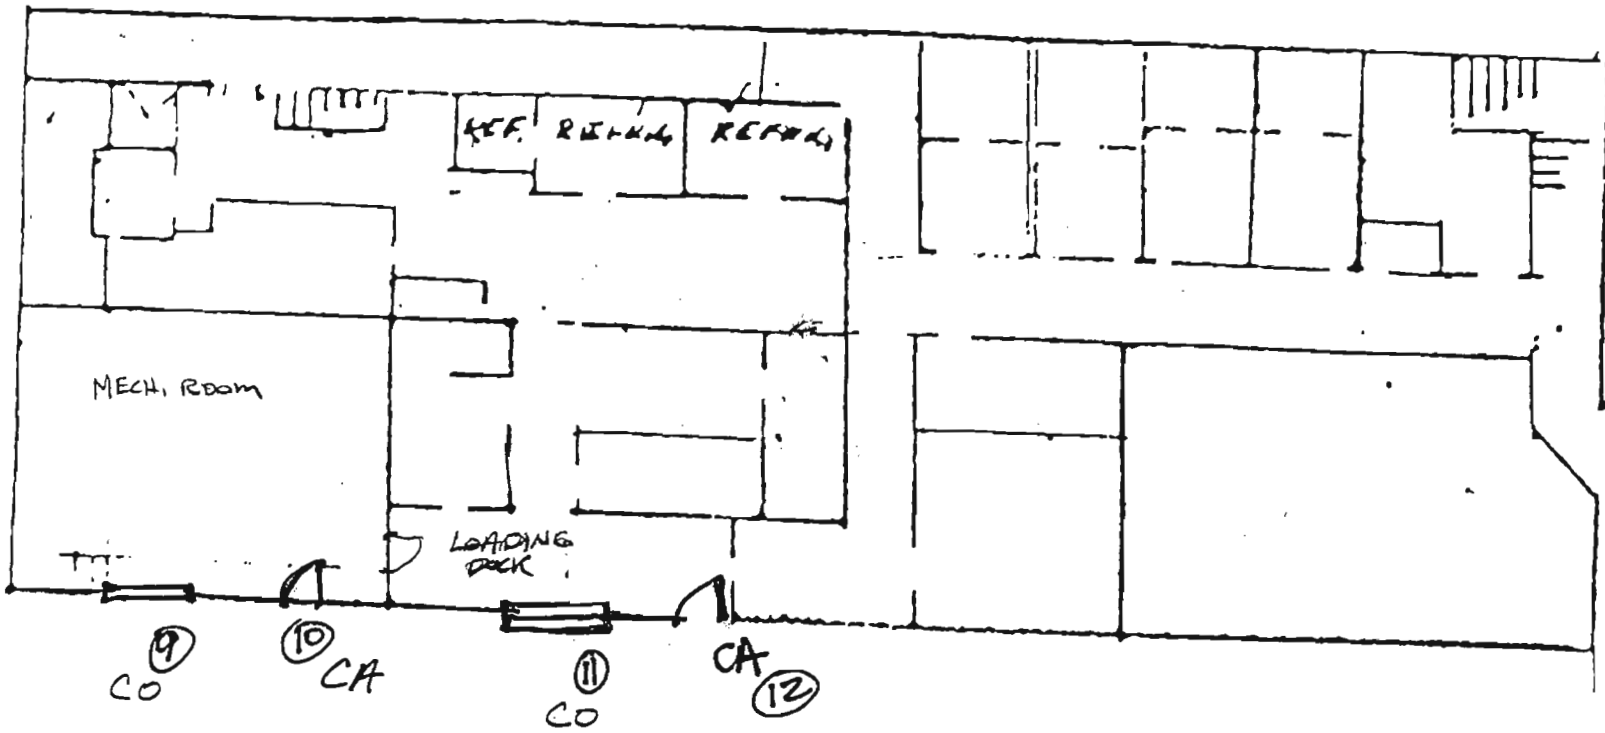

MACKIN  
BASEMENT




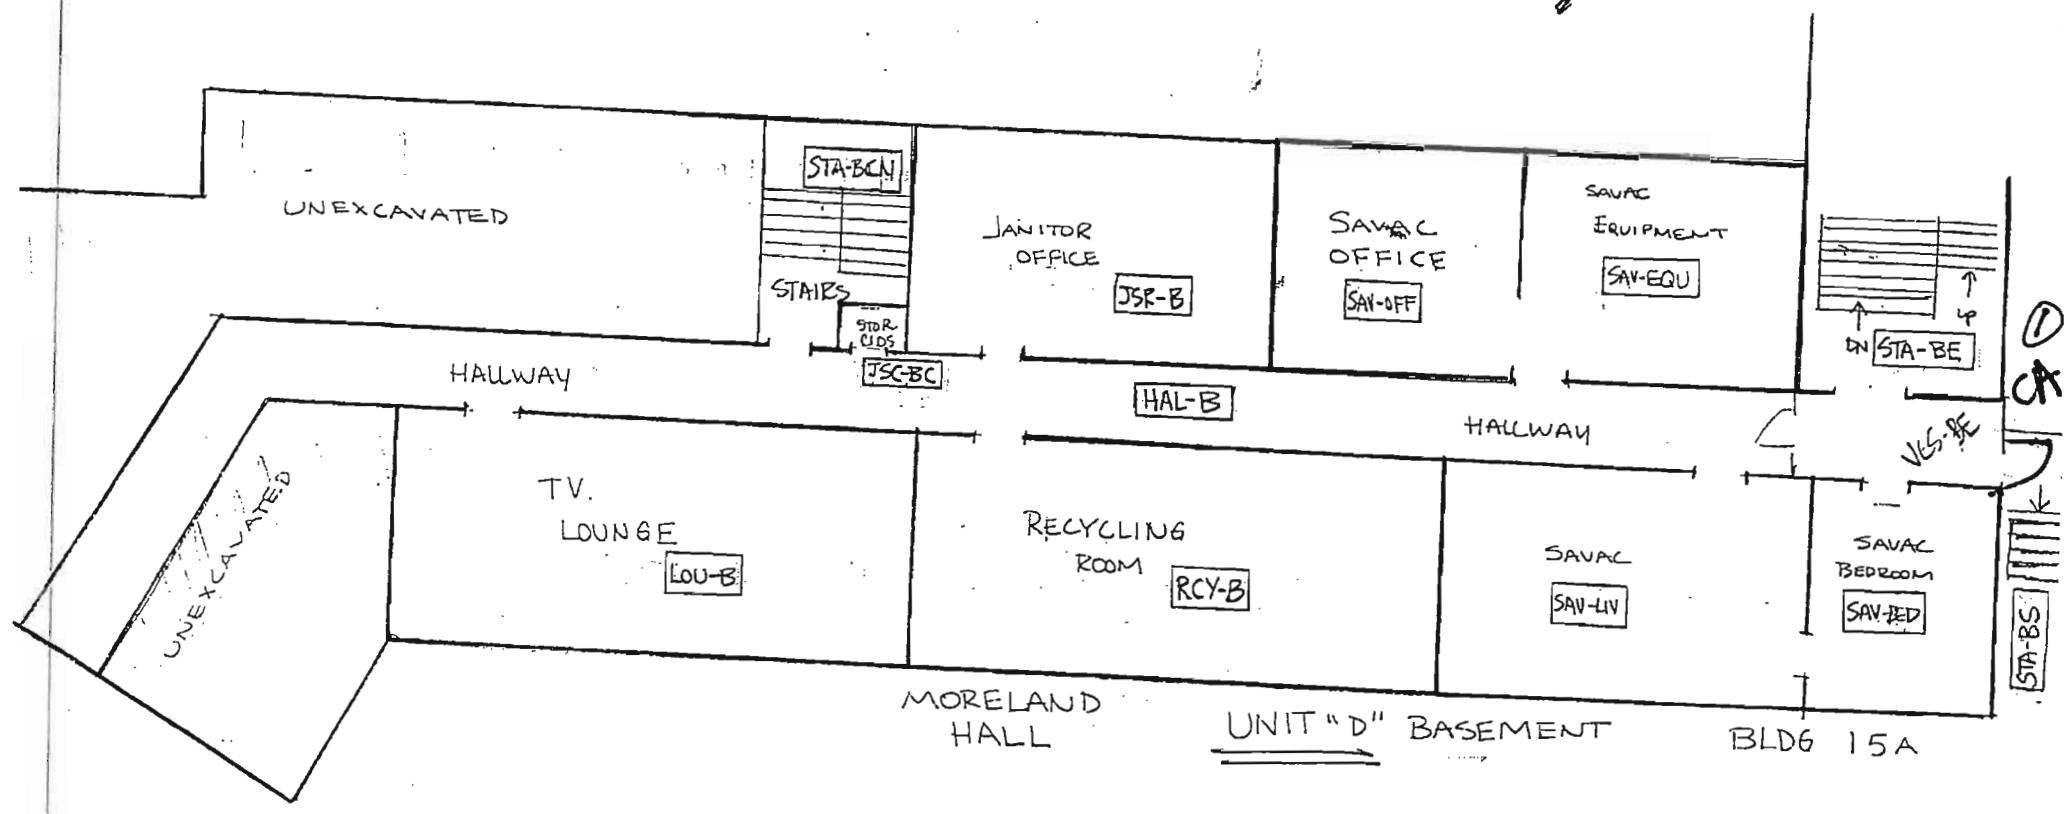

MORELAND HALL      UNIT "D" BASEMENT      BLDG 15A

MORELAND  
BSMT.  
UNIT "D"

~ WASHINGTON BLVD. ~

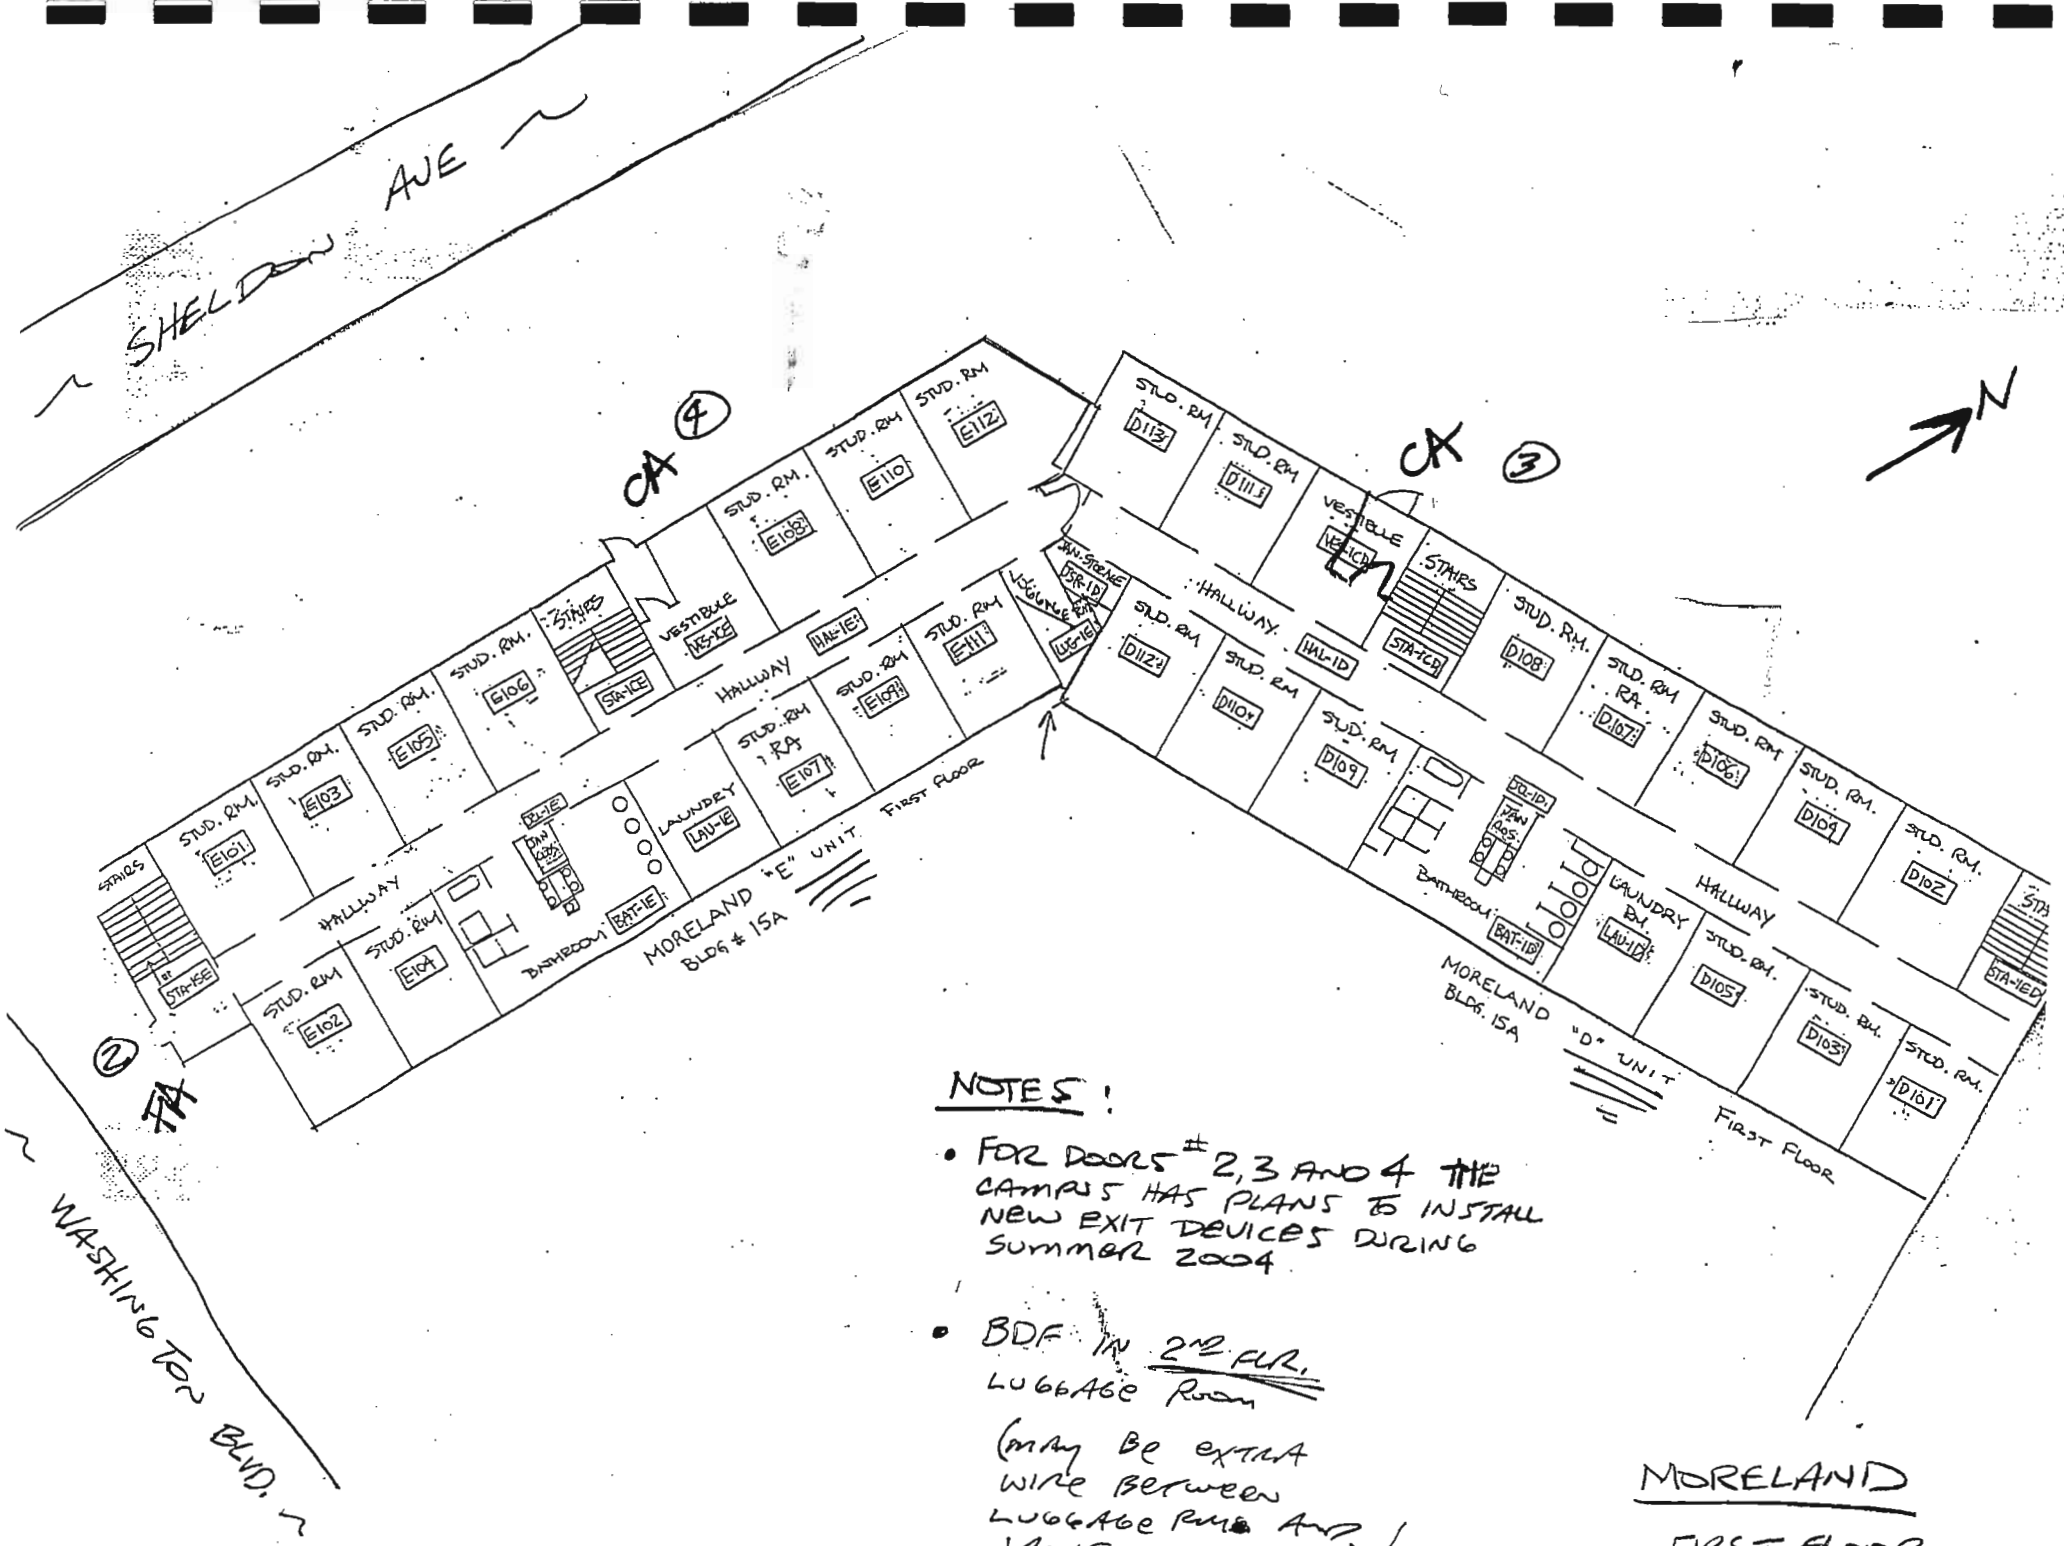



NOTES:

- FOR DOORS # 2, 3 AND 4 THE CAMPUS HAS PLANS TO INSTALL NEW EXIT DEVICES DURING SUMMER 2004.
- BDF IN 2<sup>ND</sup> FLR. LUGGAGE ROOM (MAY BE EXTRA WIRE BETWEEN LUGGAGE ROOM AND JANITOR CLOSET.)

MORELAND  
FIRST FLOOR



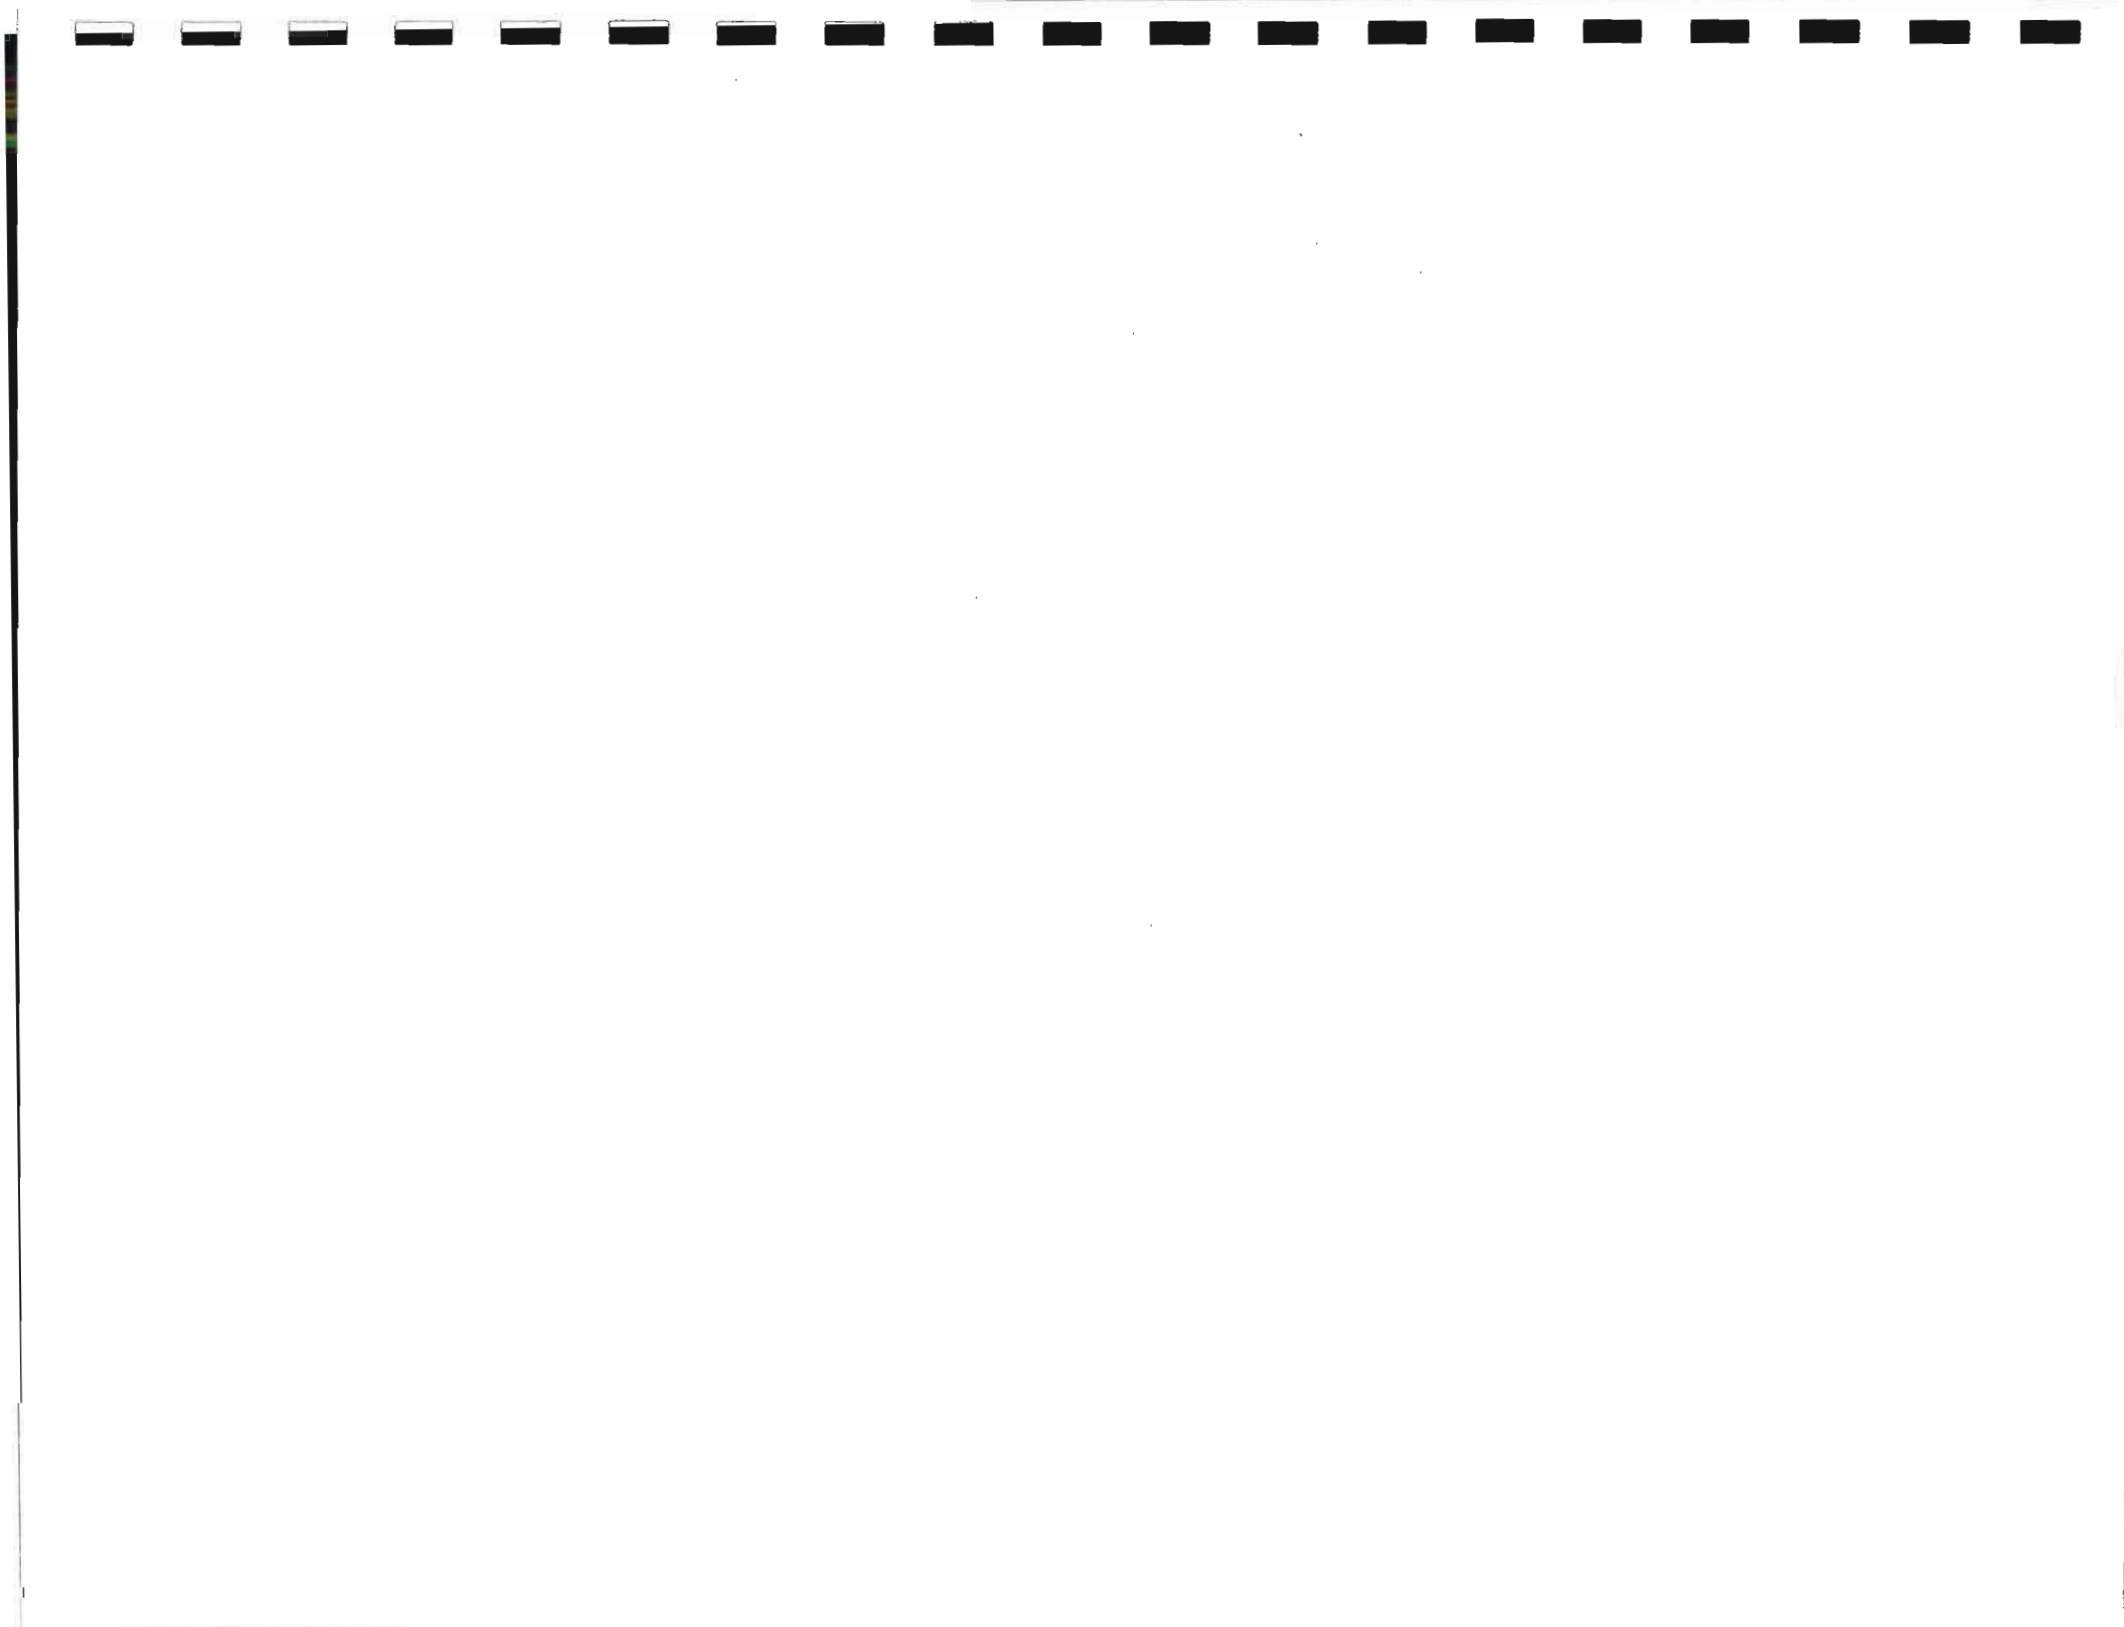

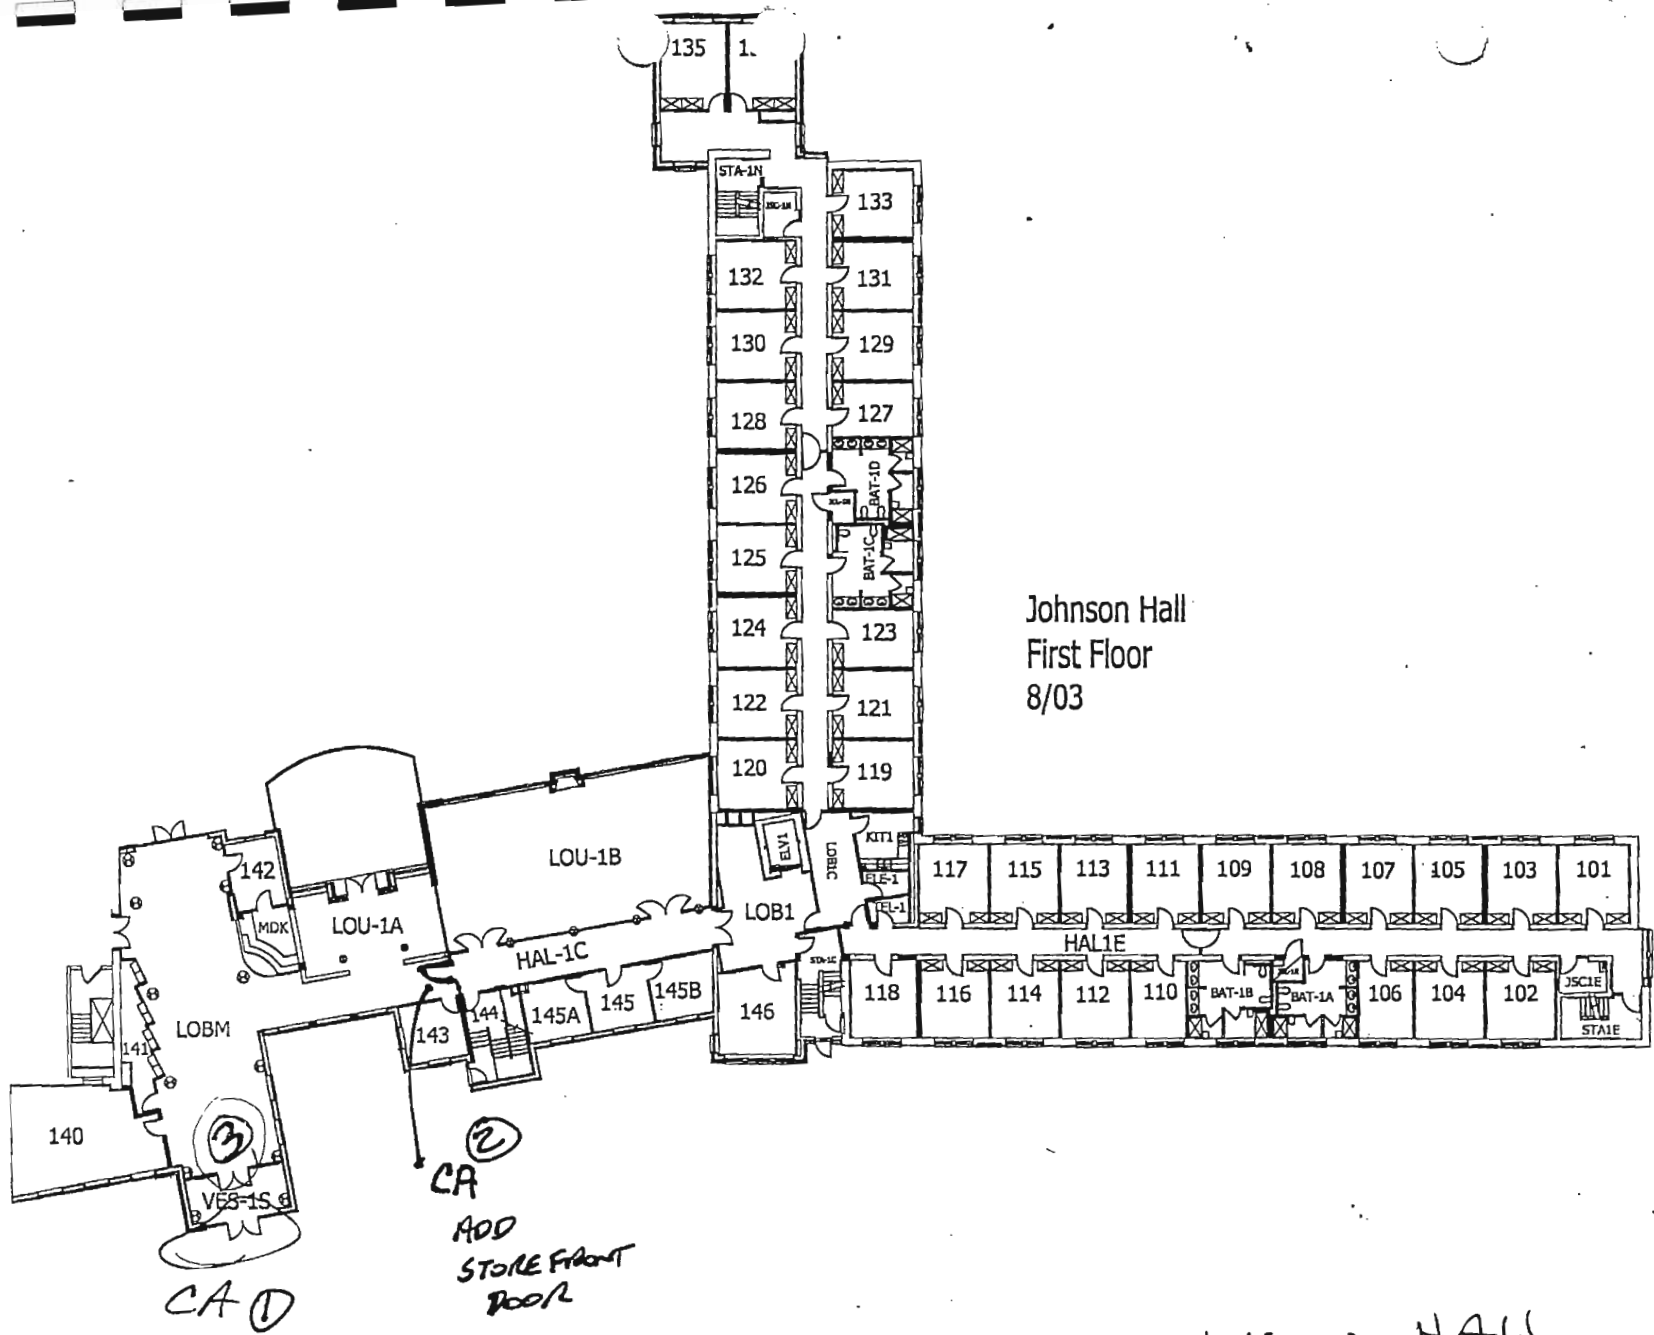


Johnson Hall  
First Floor  
8/03

CA ②  
ADD  
STORE FRONT  
DOOR

CA ①


JOHNSON HALL  
1<sup>ST</sup> FLR.

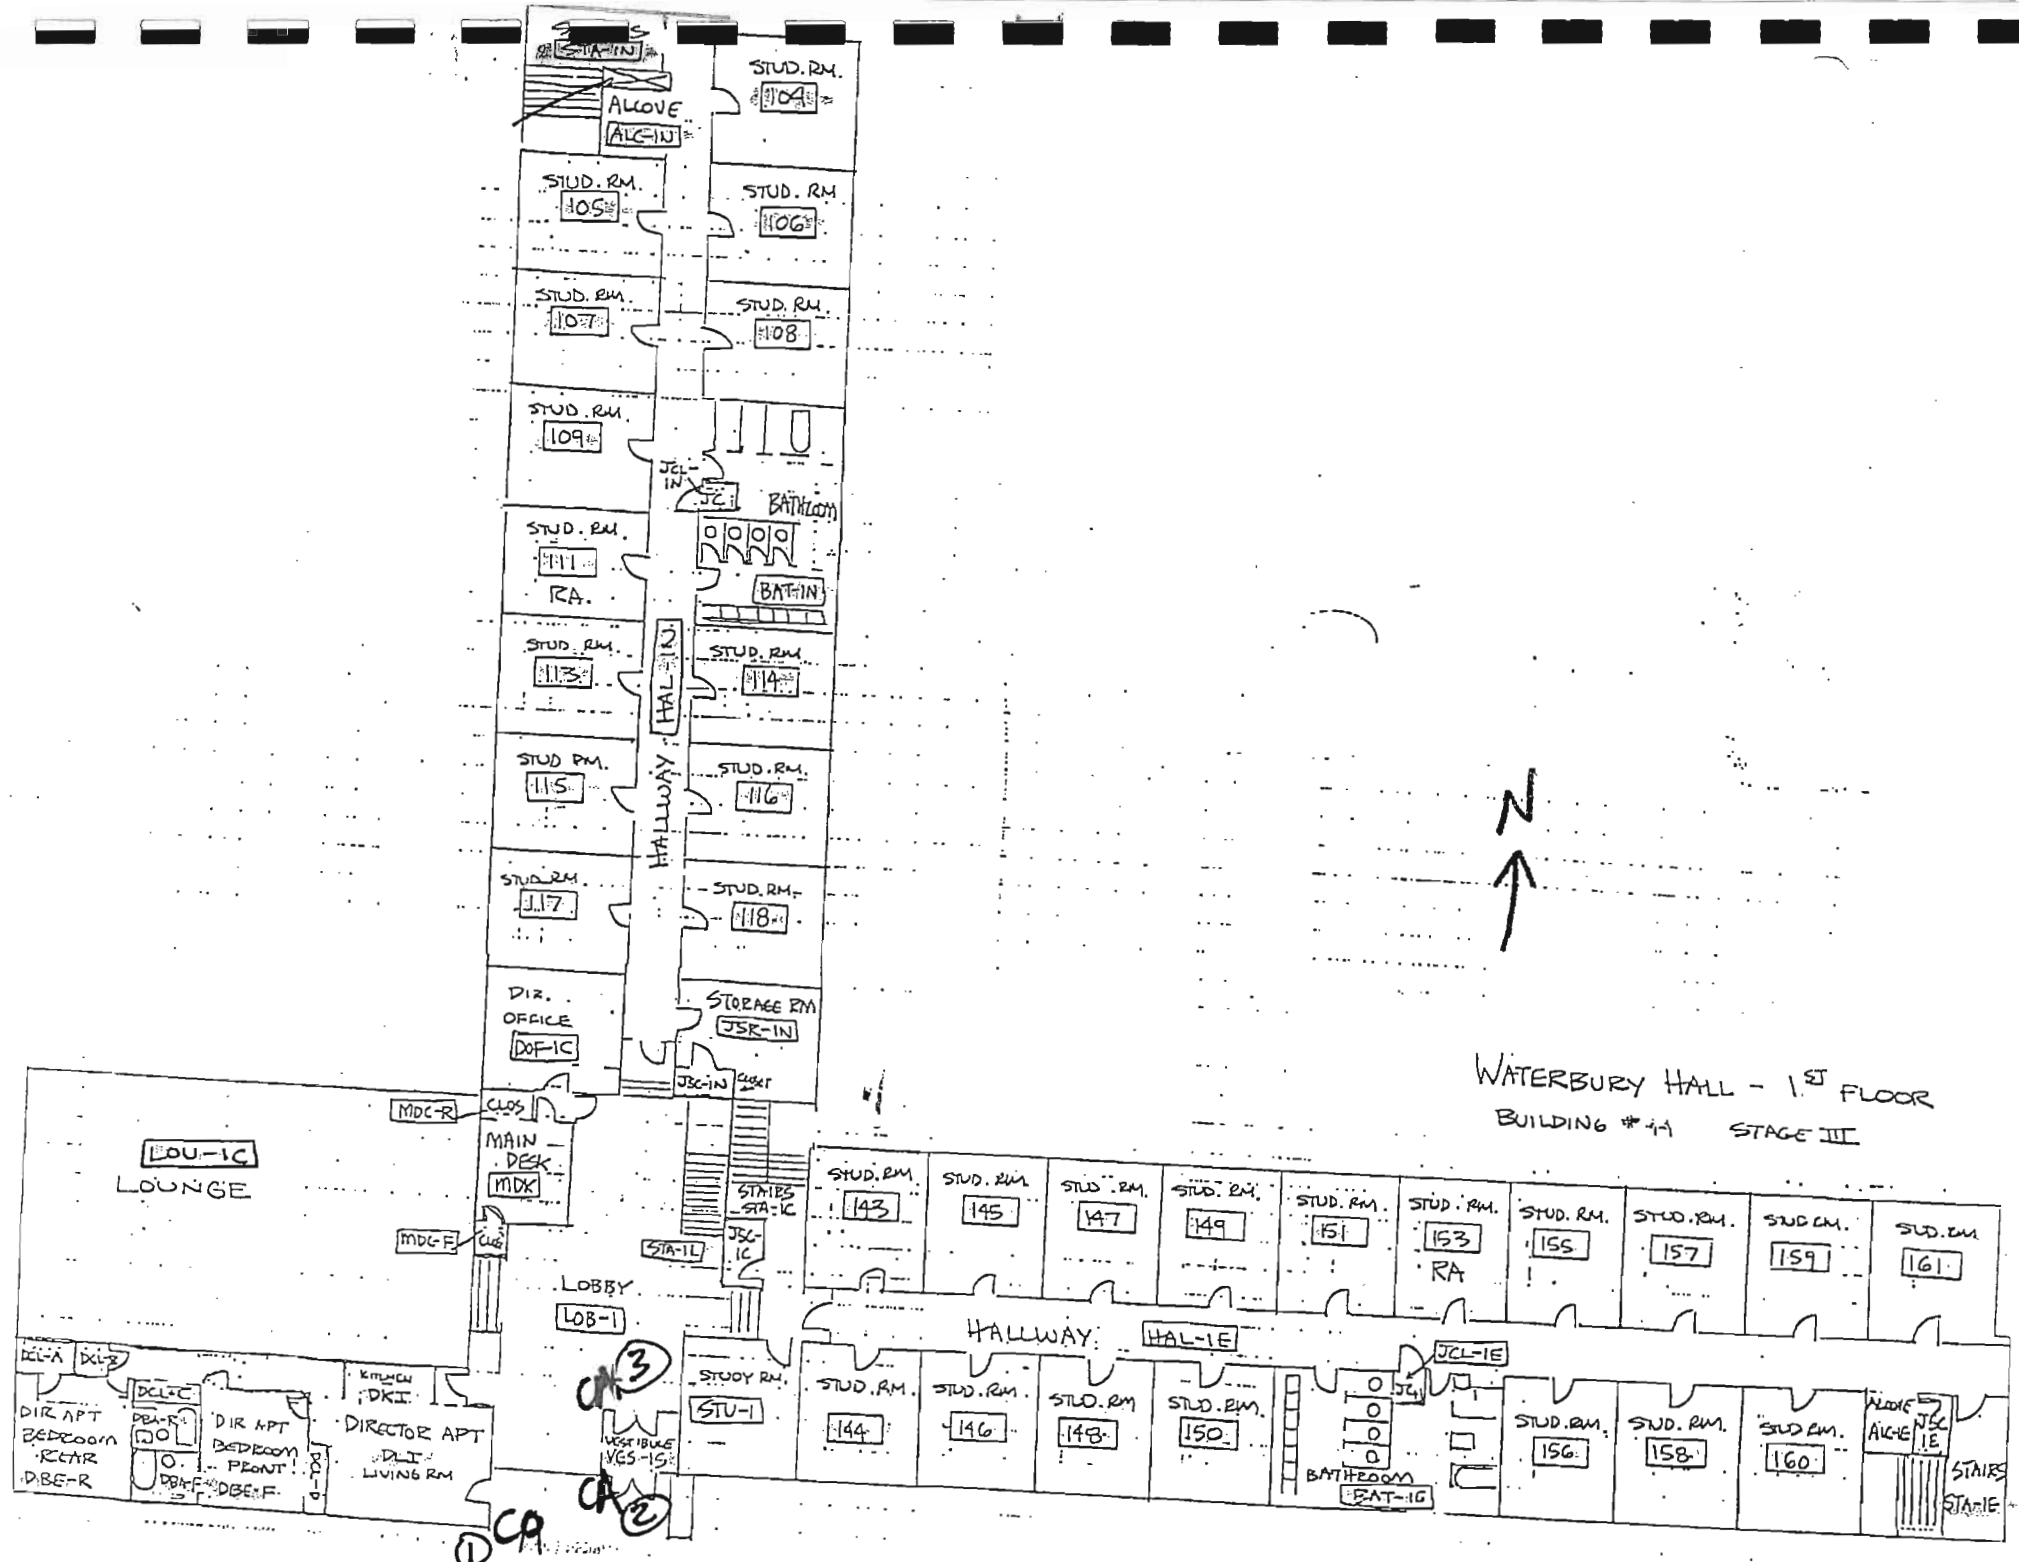


WATERBURY HALL - 1<sup>ST</sup> FLOOR  
BUILDING #41 STAGE III




① CA  
②  
③

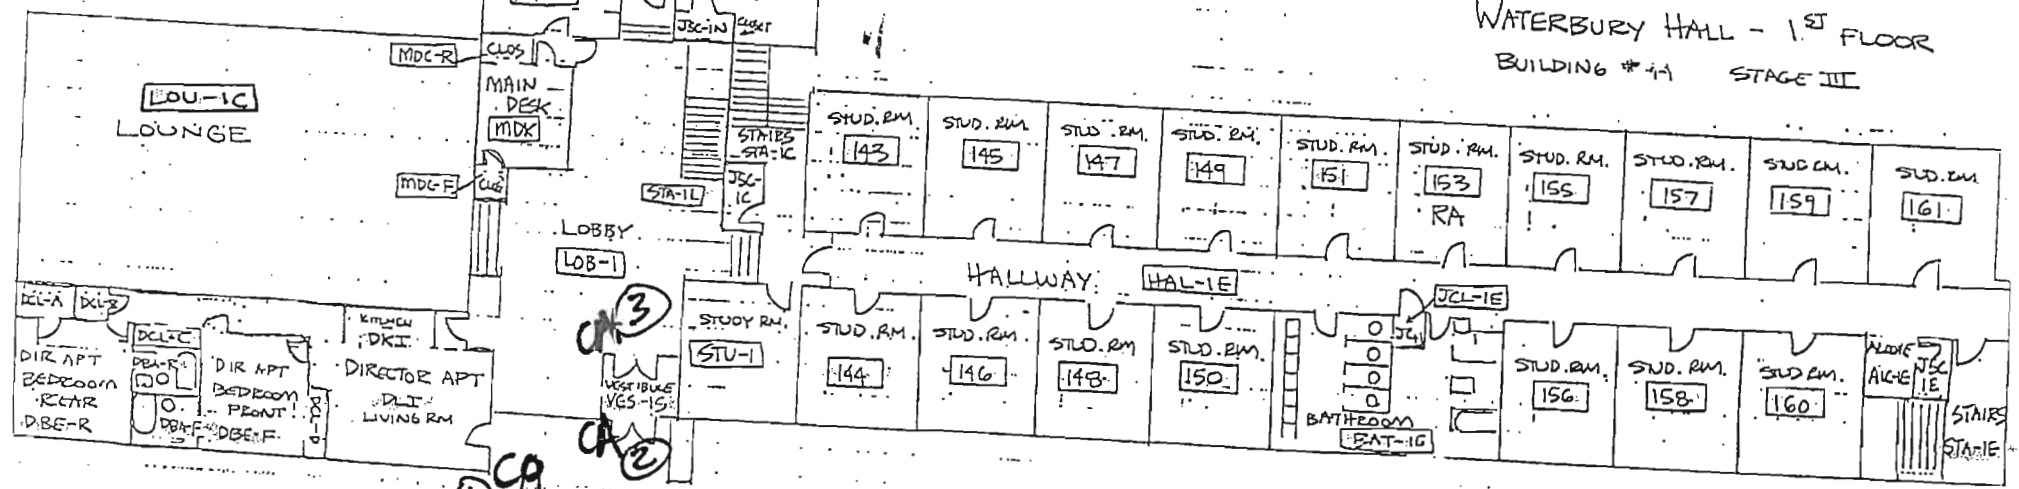


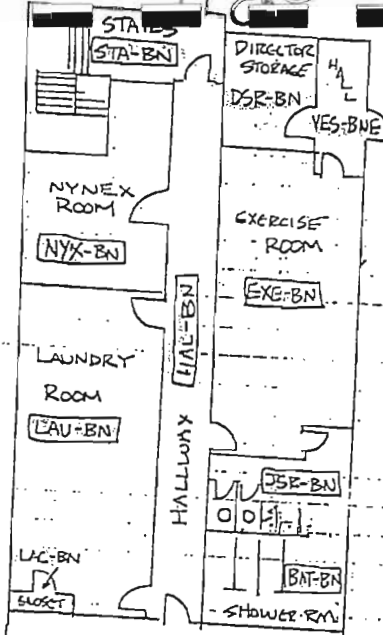

FA 7









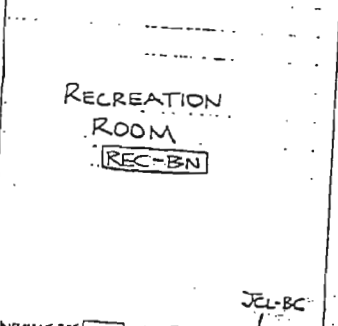


FA 9

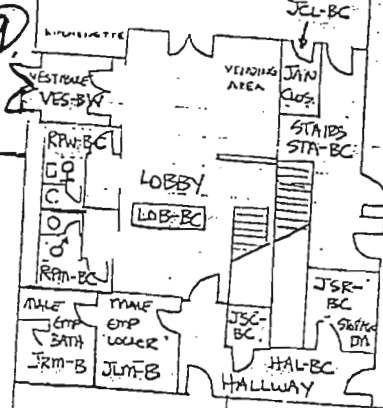


FA 6

WATERBURY HALL - BASEMENT  
BUILDING #44 STAGE III

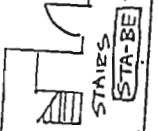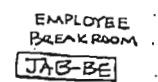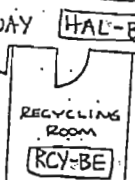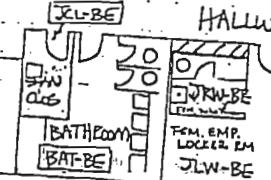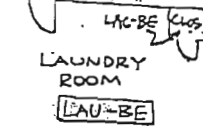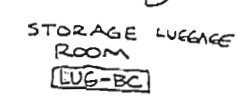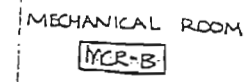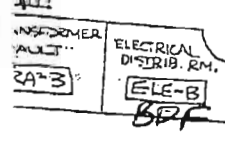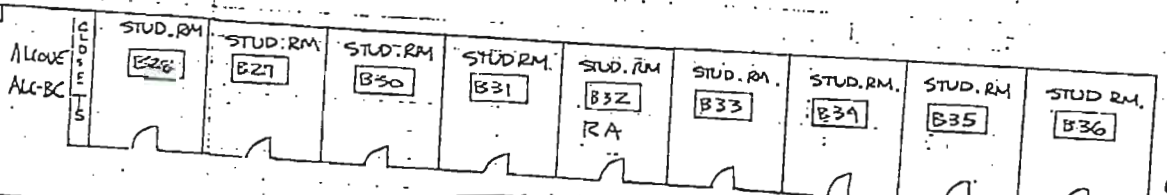


CA 5

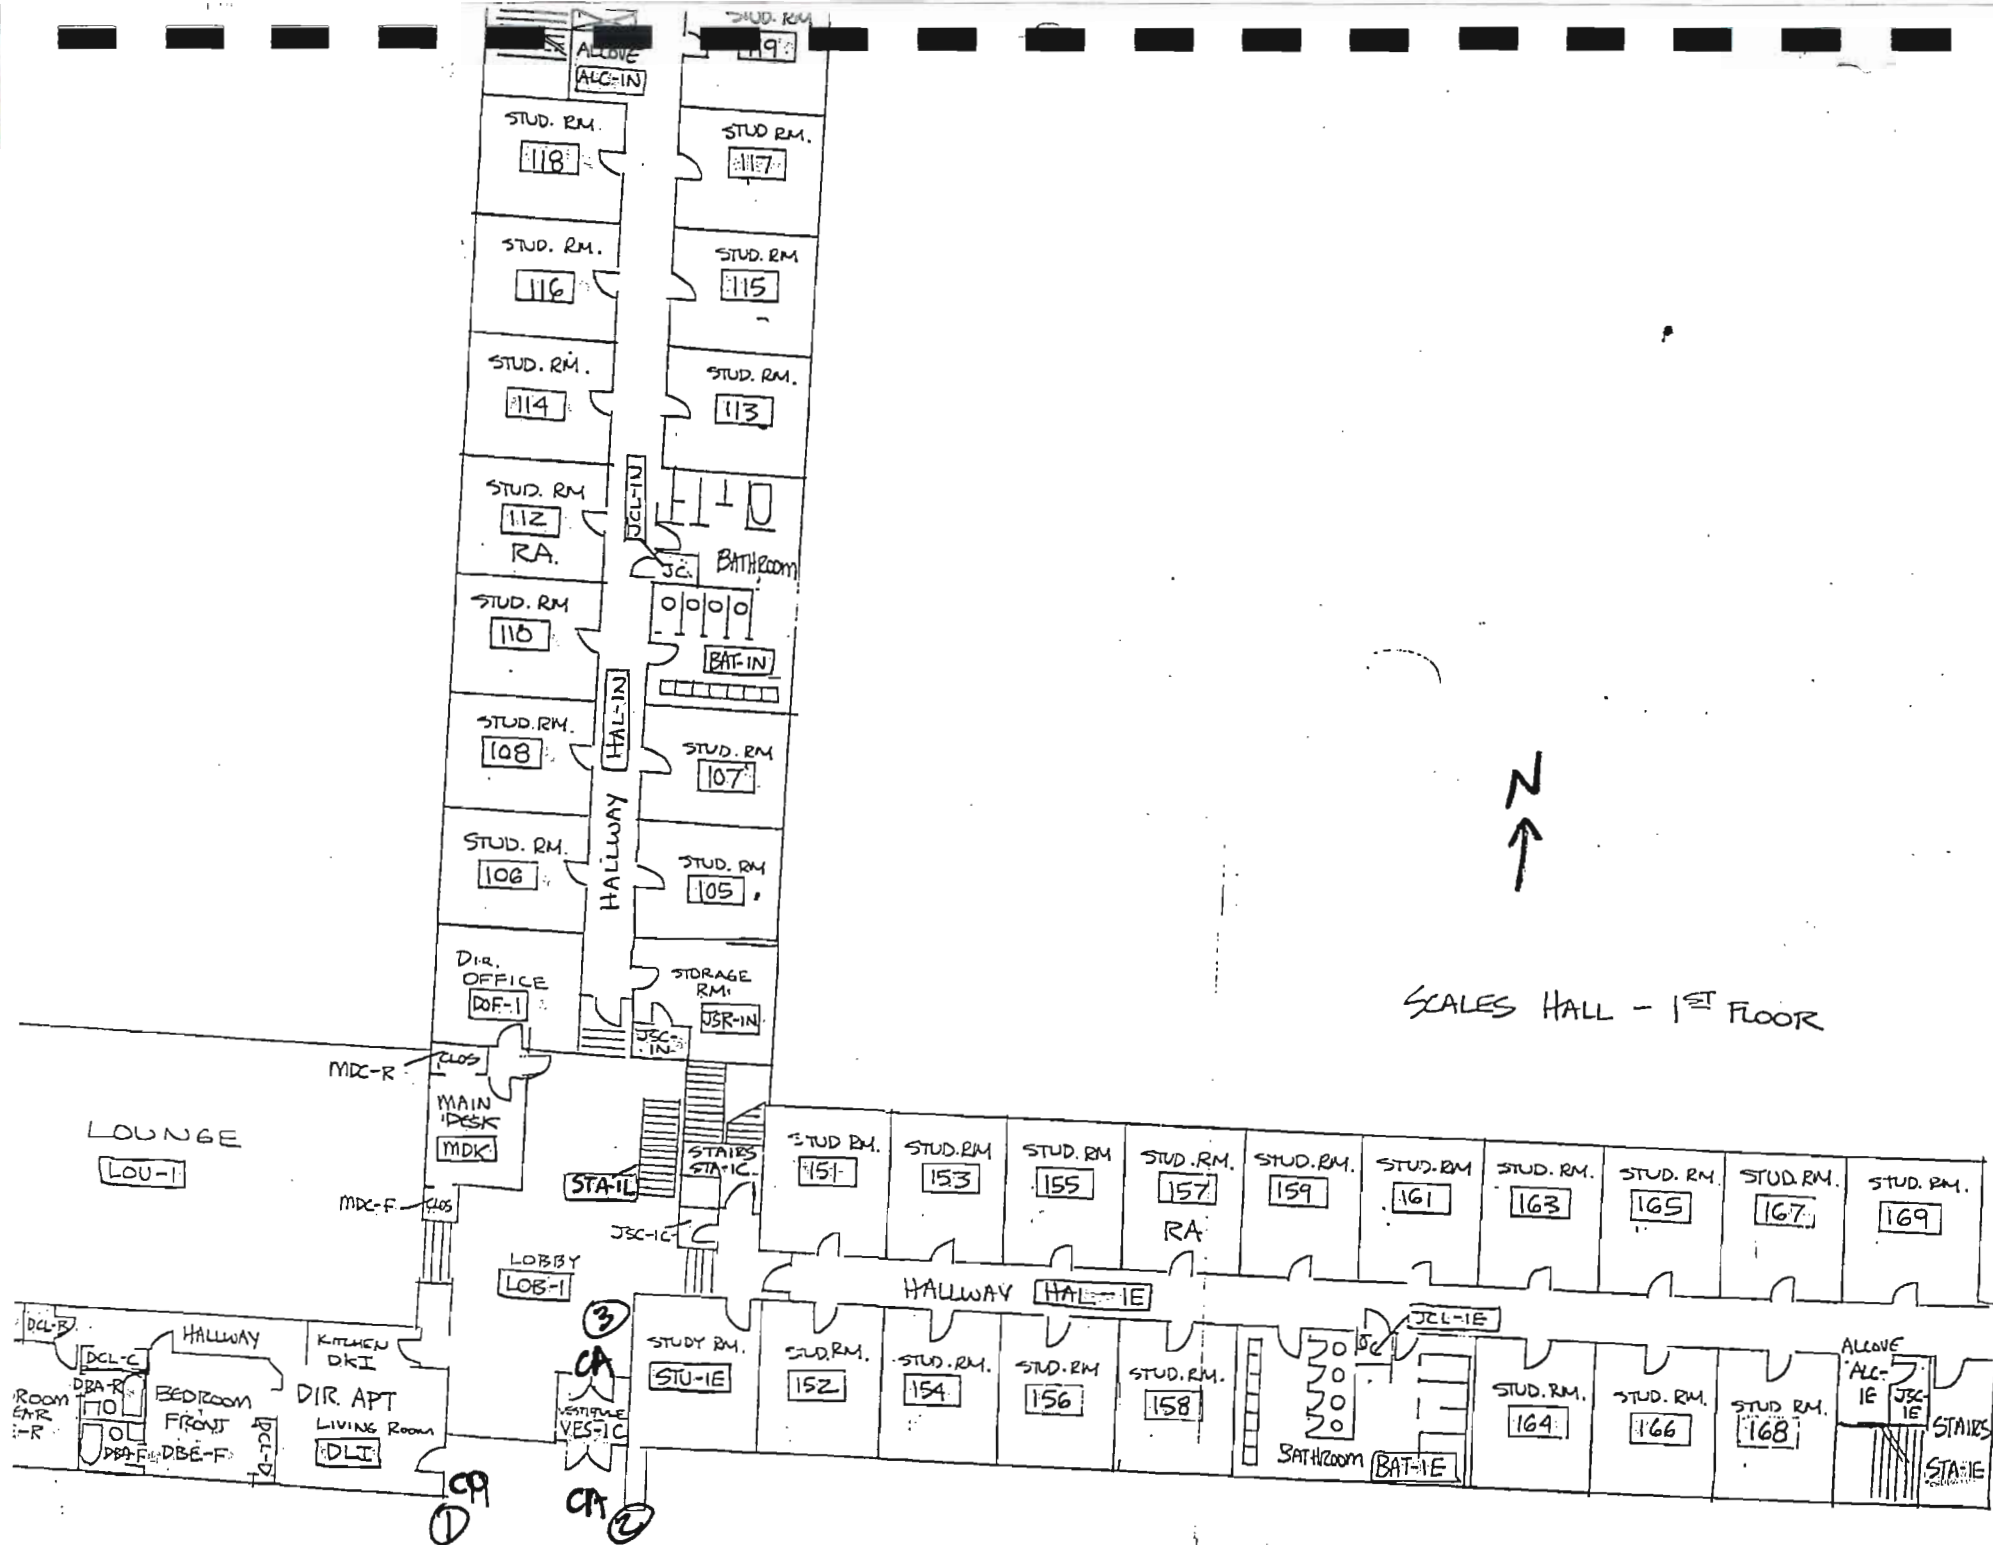


SCALES HALL - 1<sup>ST</sup> FLOOR



①  
 CA  
 VESTIBULE  
 YES-1C  
 CA  
 ②  
 ③

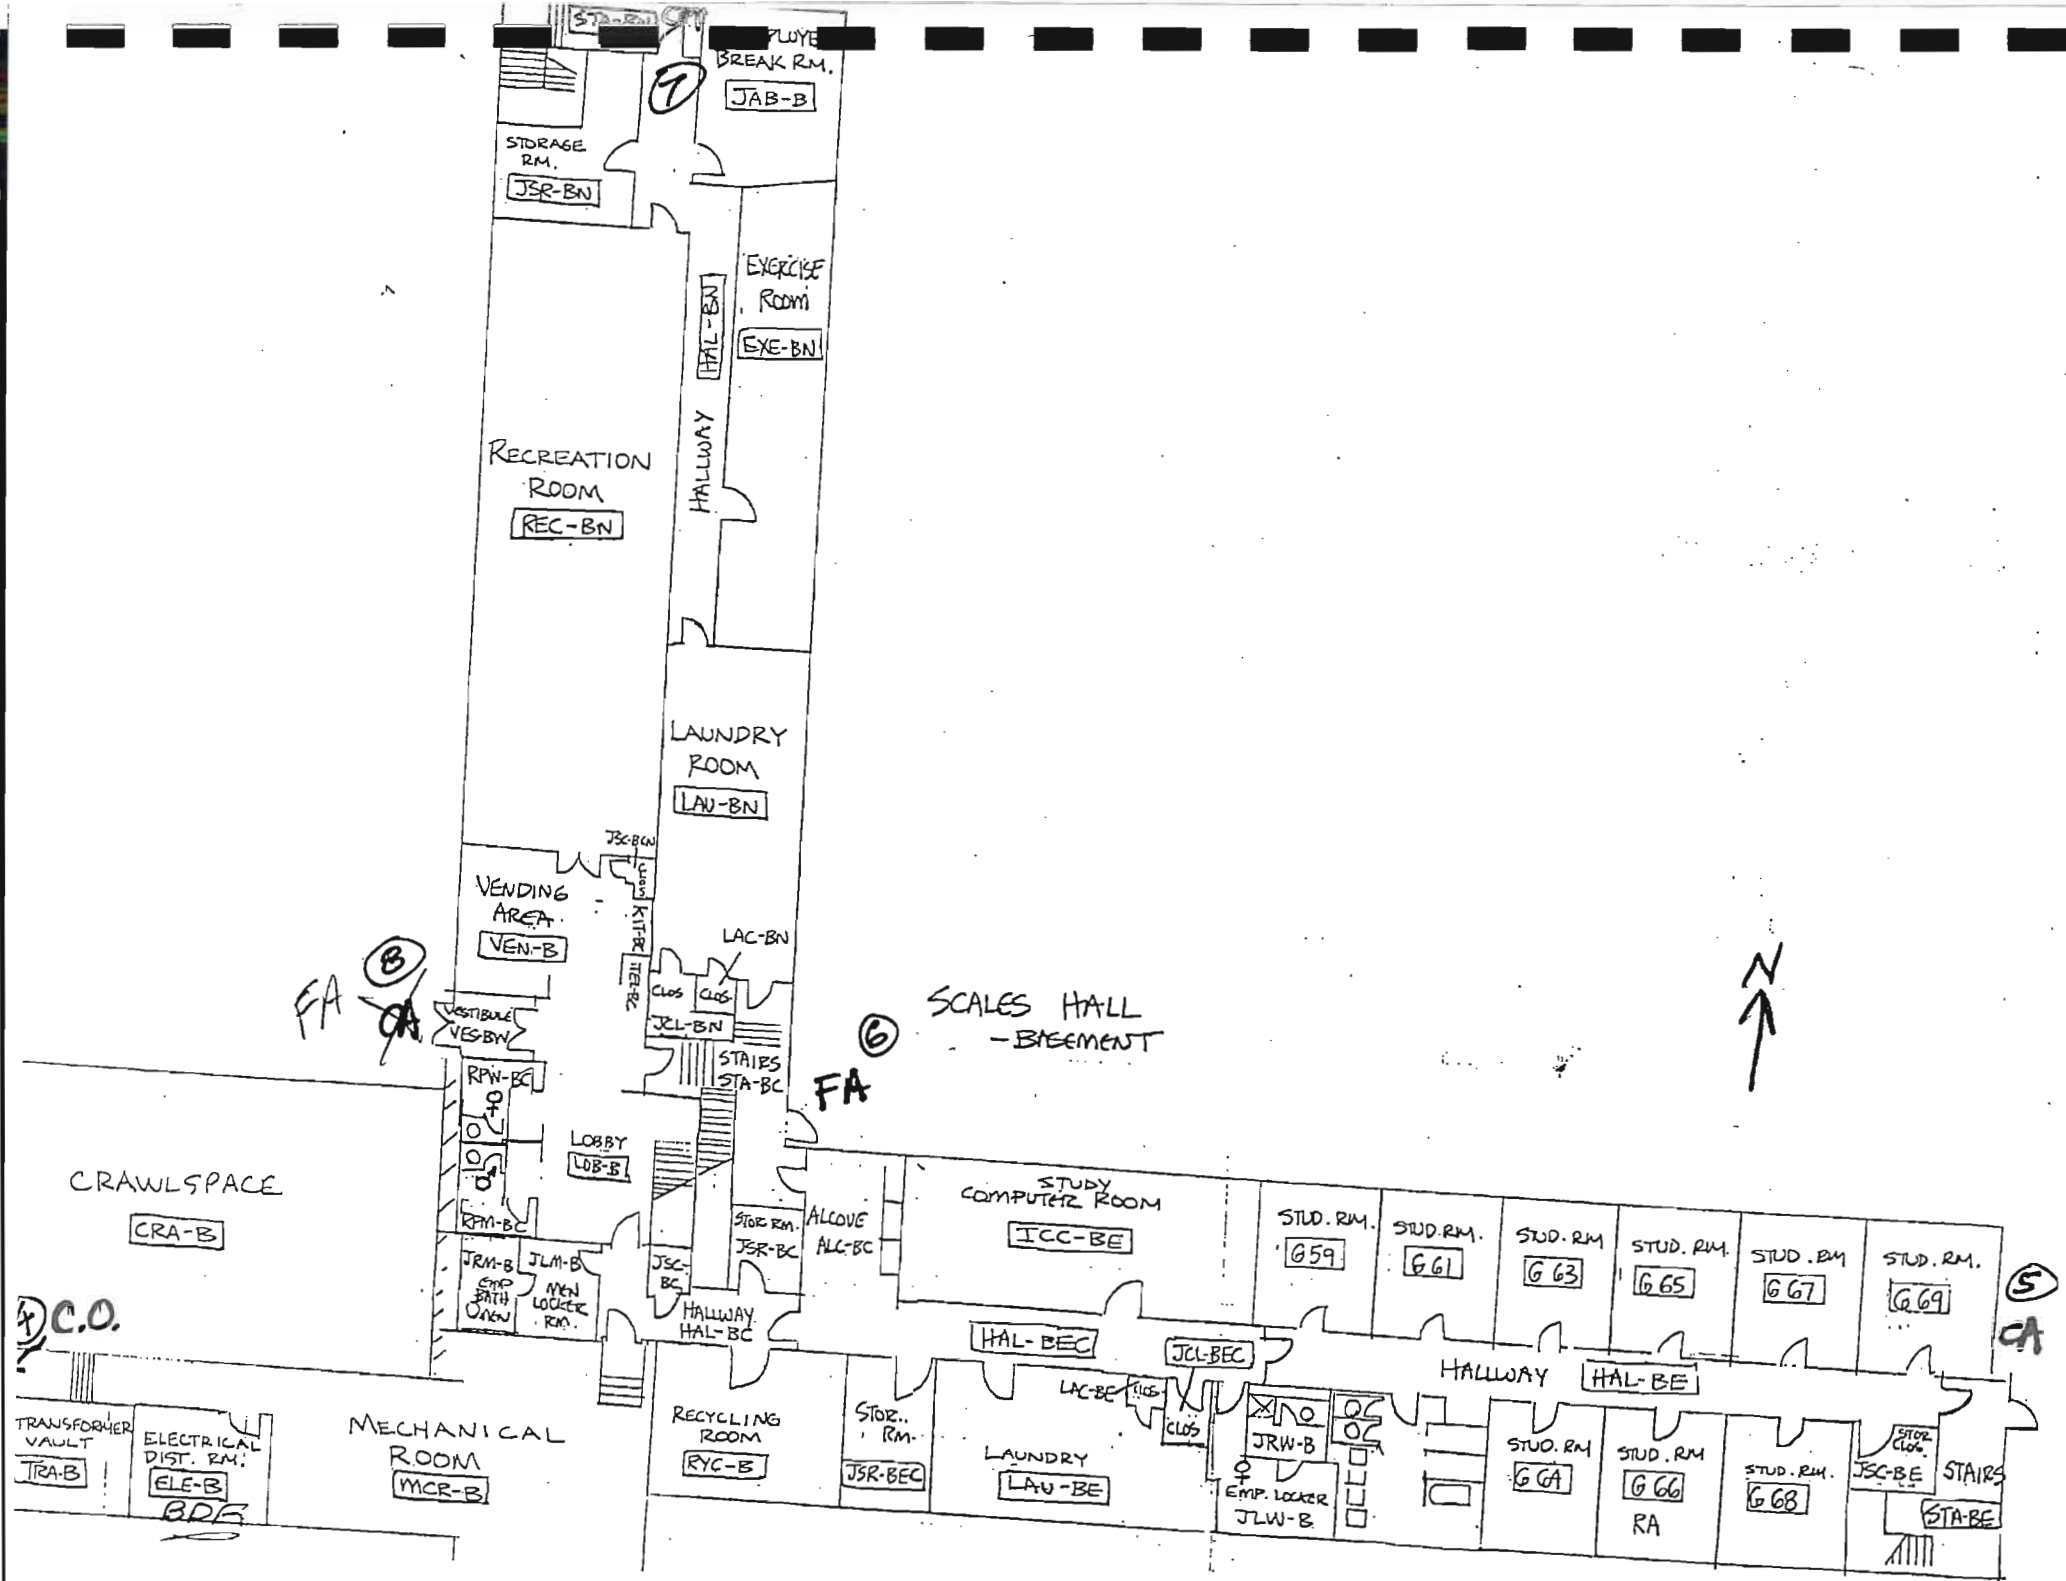

N ←

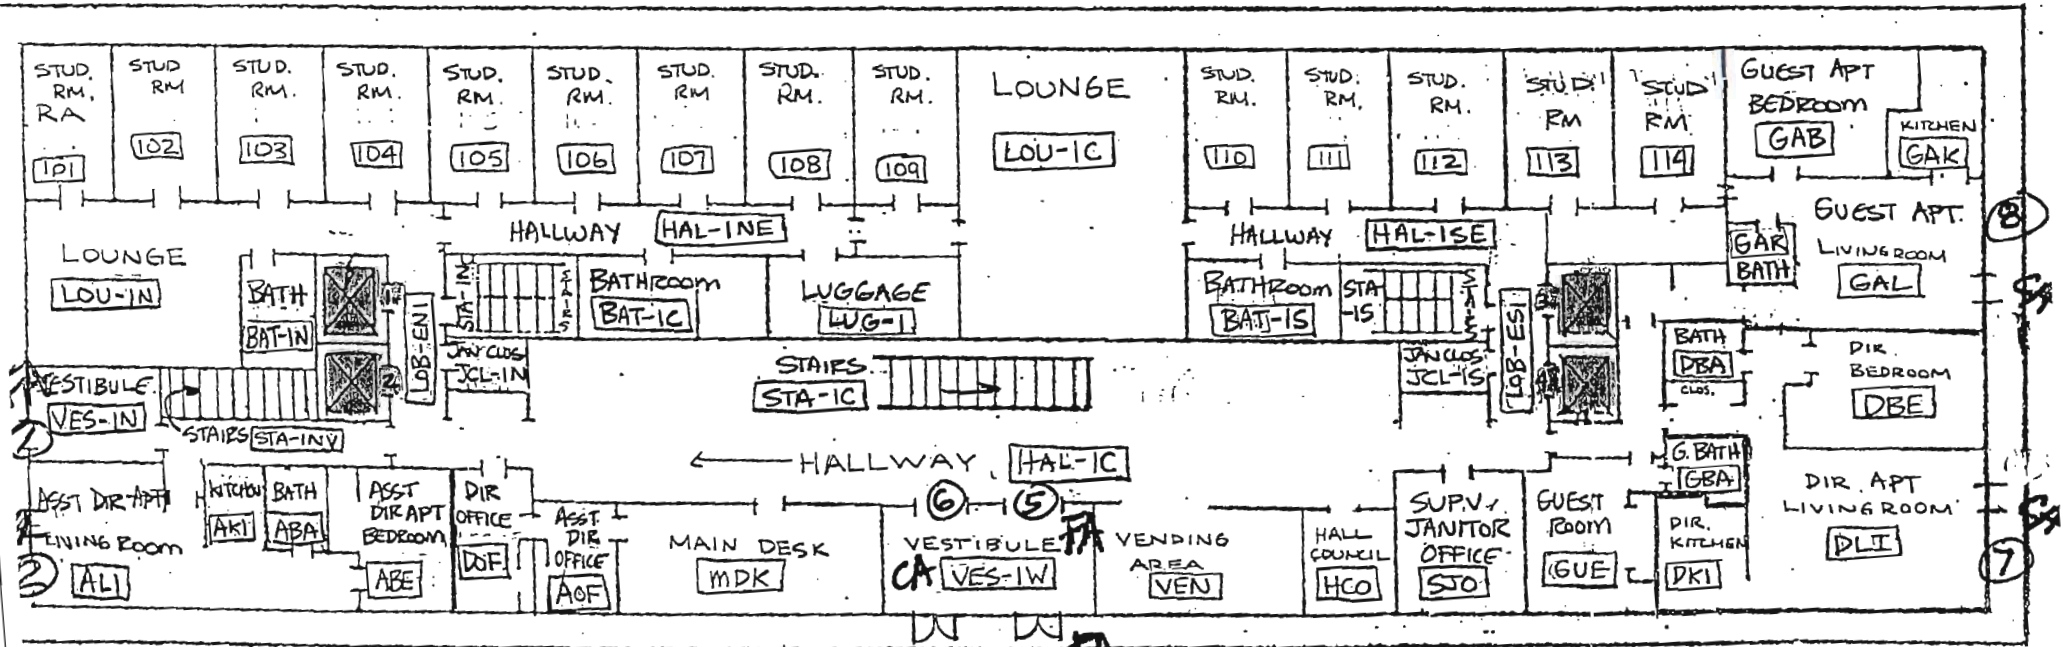


SENECA HALL - 1ST FLOOR

RECOMMEND  
NEW ROOM  
BY THIS  
PROJECT

NEW  
2-2004

9  
CA

10  
CA

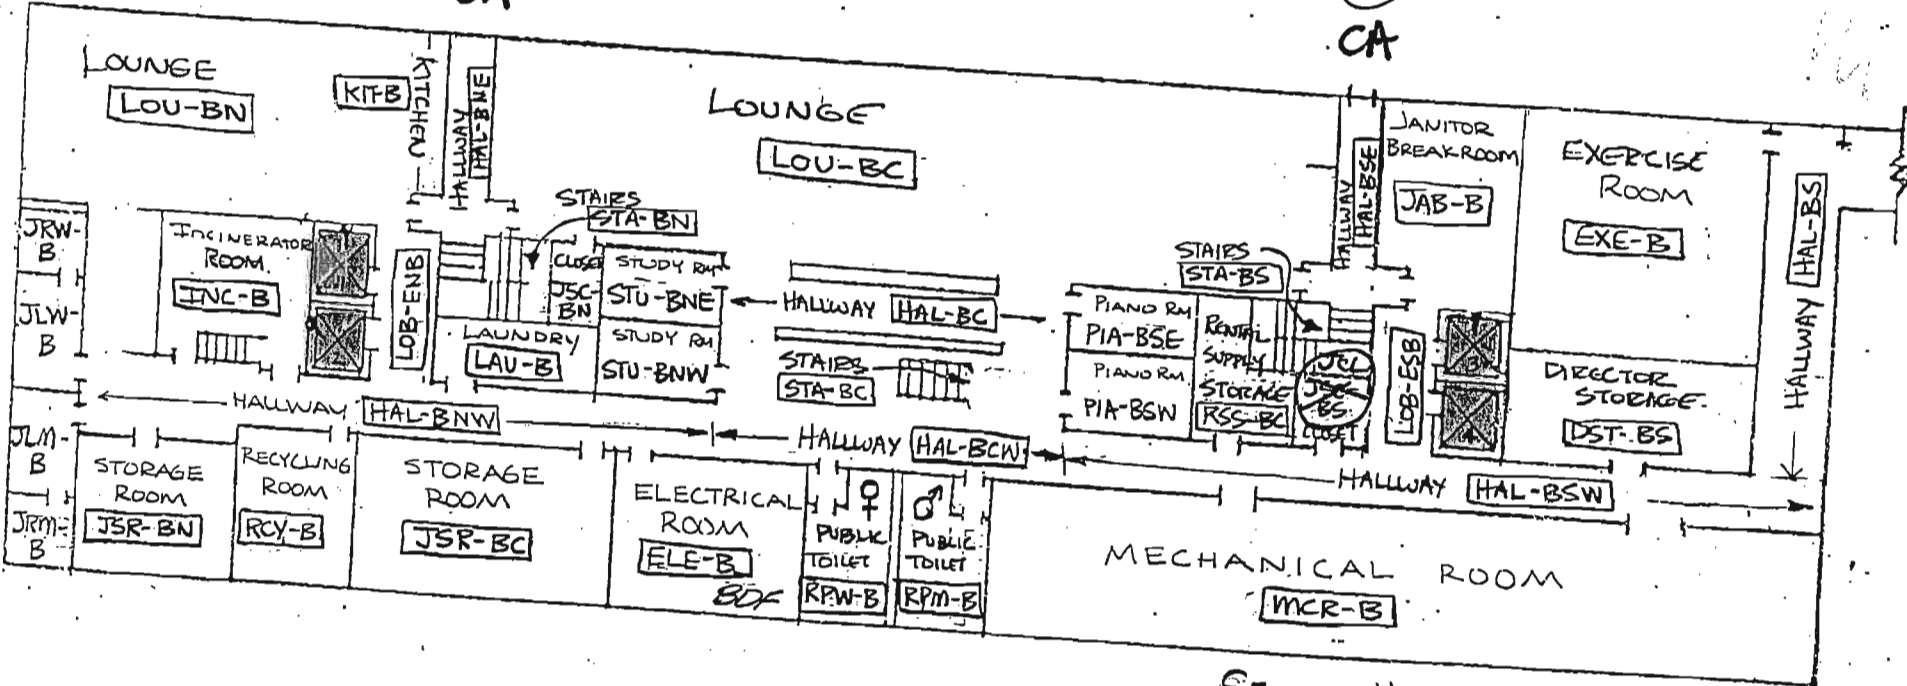


SENECA HALL - BASEMENT






↑ TO CAYUGA  
C.A. ①

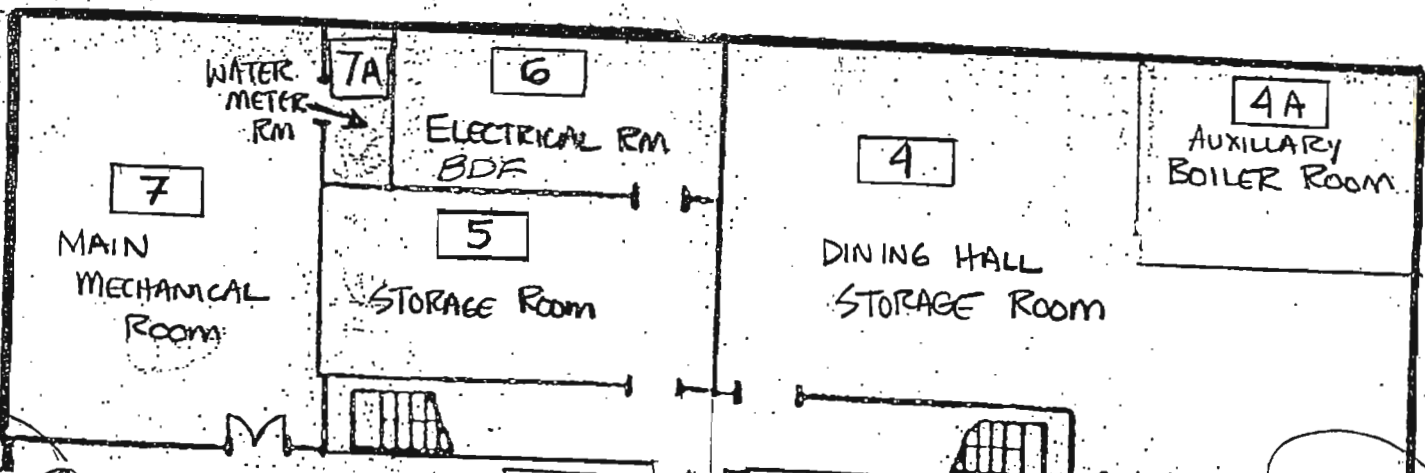

④ CA  
↑ TO SENECA


② CA  
TUNNEL TO CAYUGA

③ FA  
TUNNEL TO SENECA

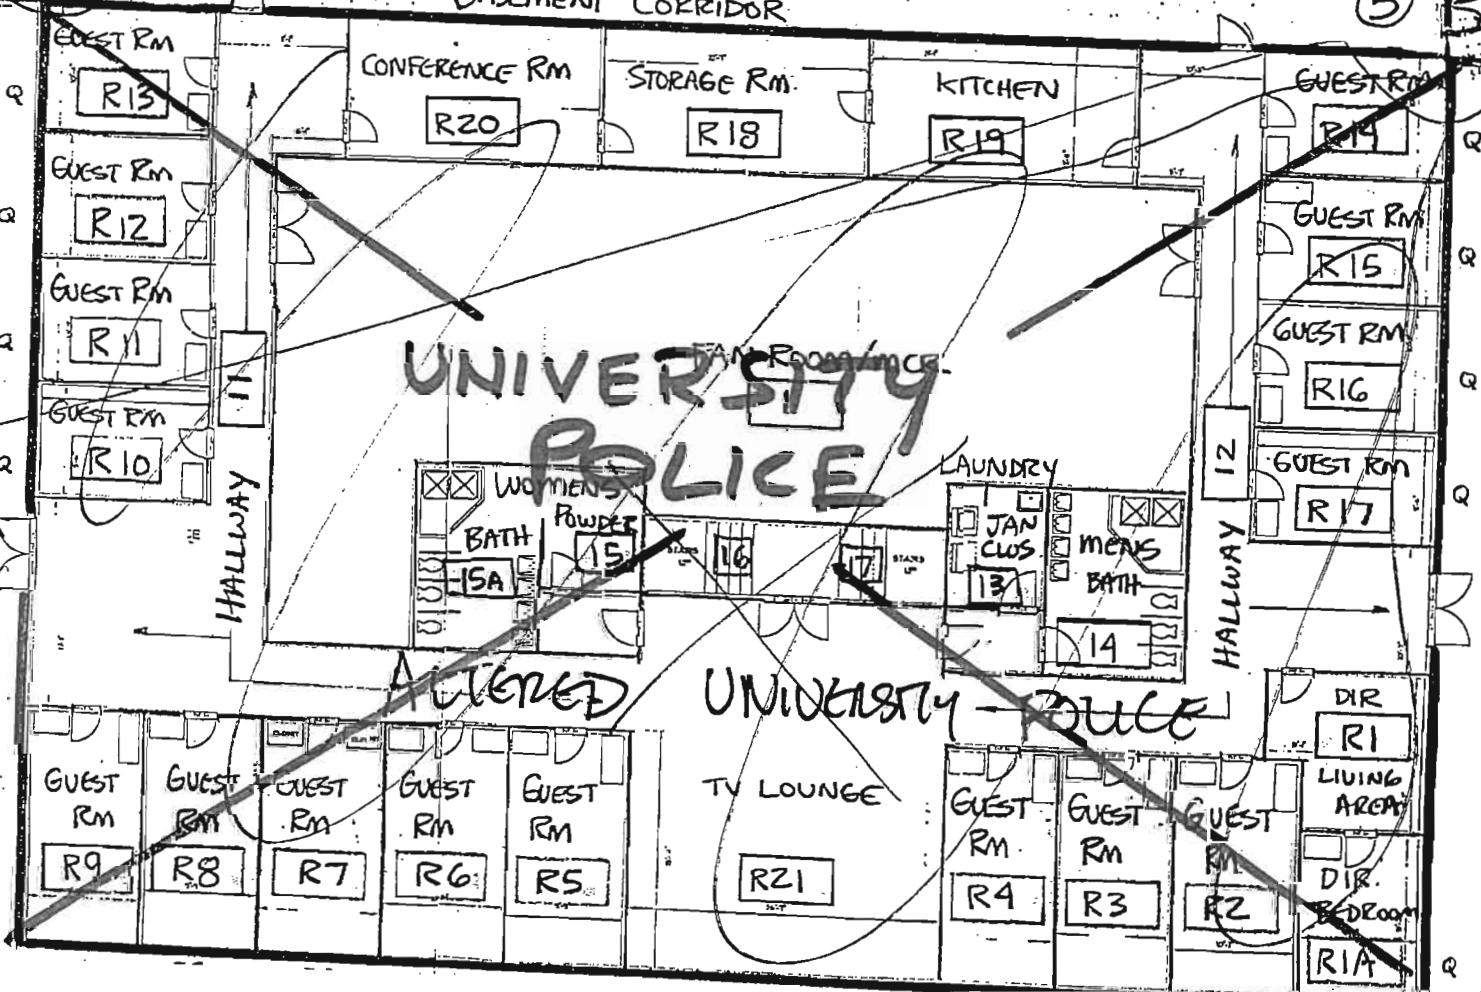

↑ N

PATHINDER HALL  
BASEMENT LEVEL  
BLDG 31  
STAGE VIII

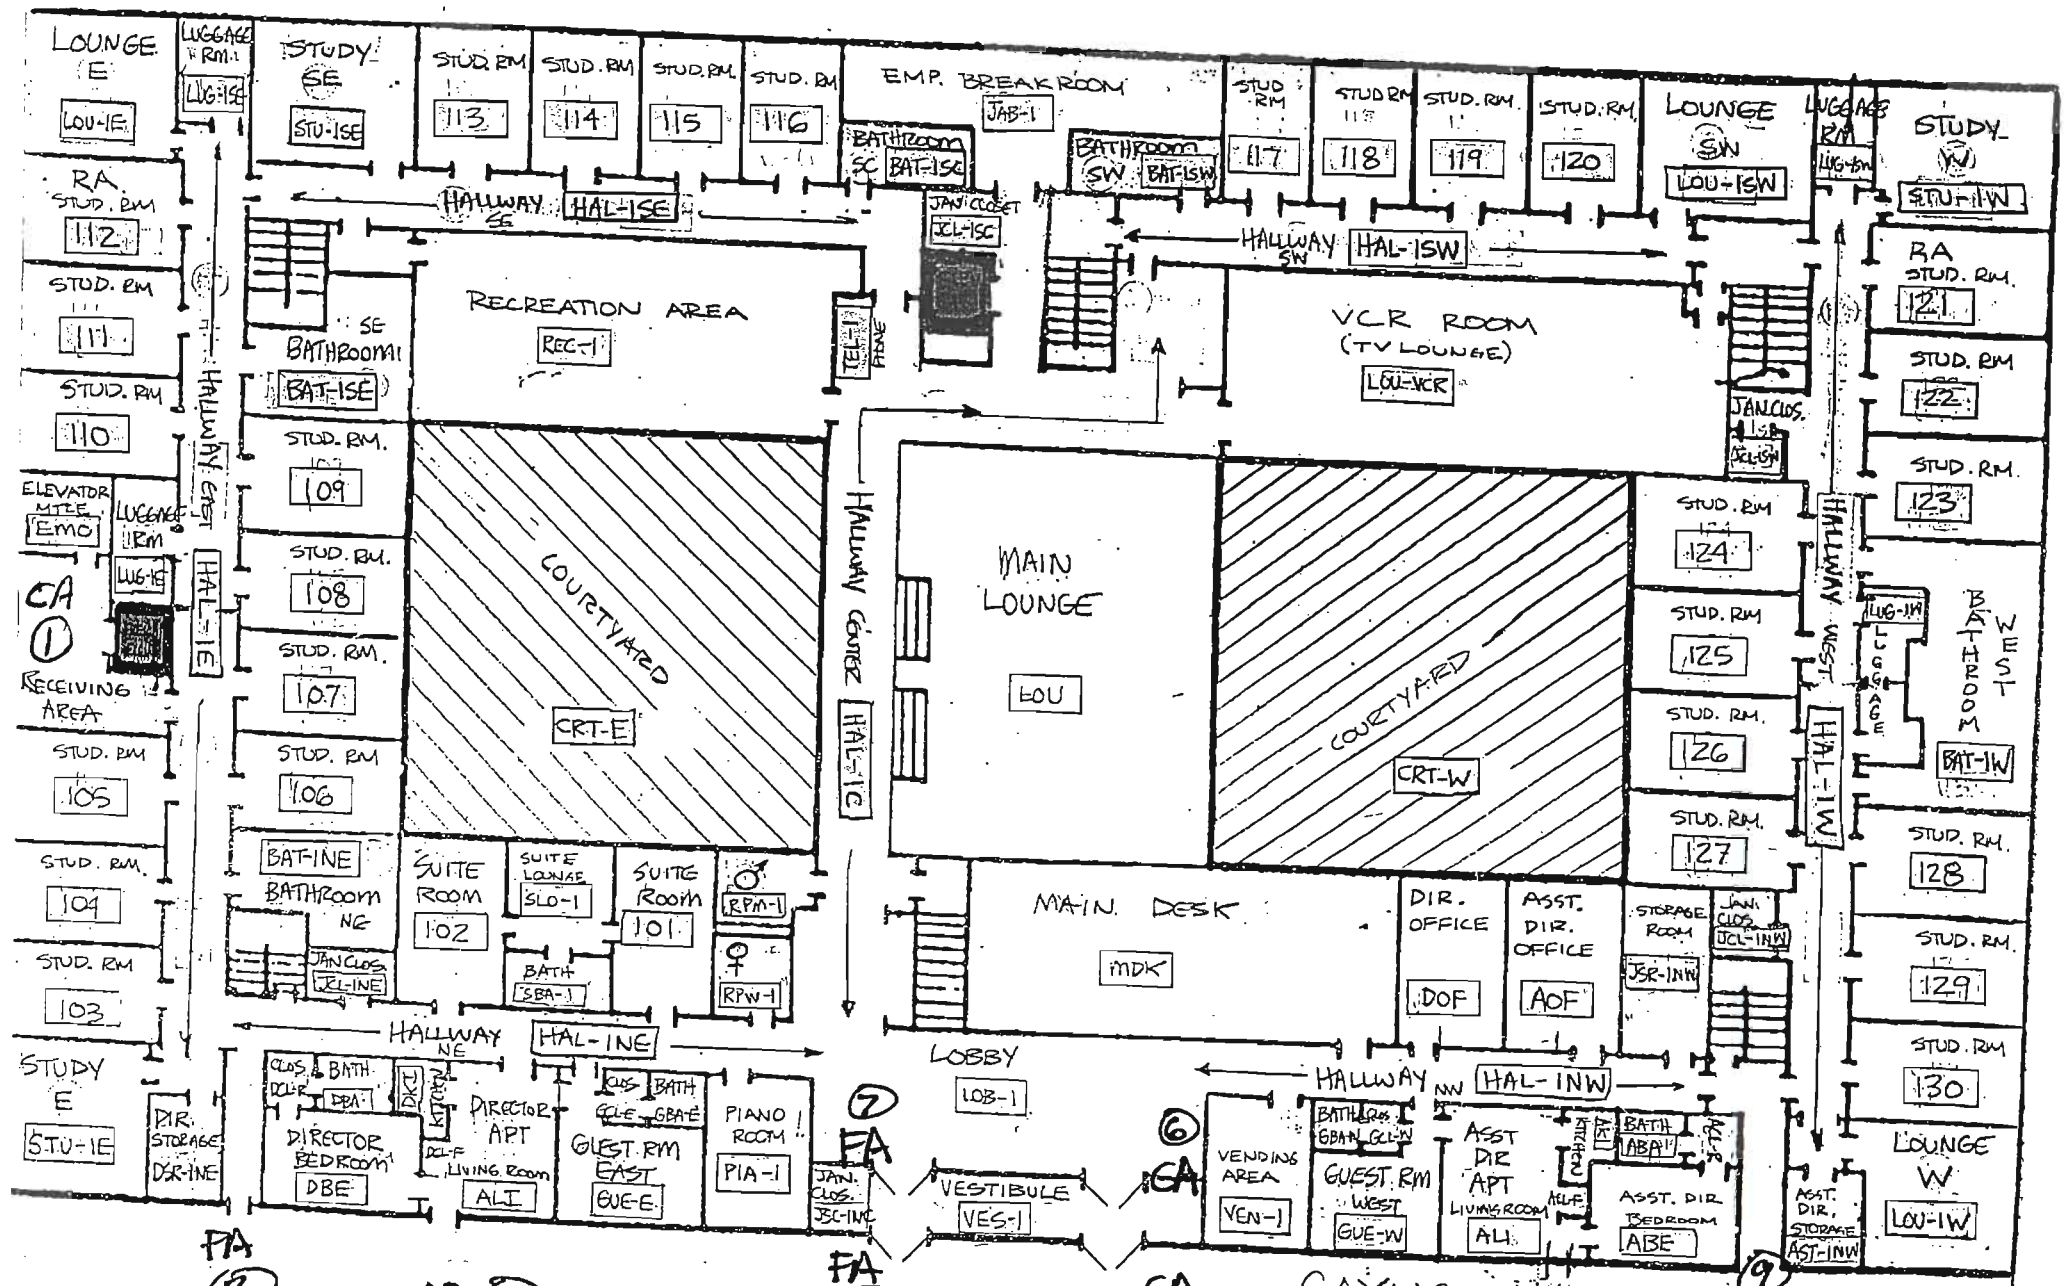

CAYUGA HALL - FIRST FLOOR

FA ②


CA ③

FA ④


CA ⑤

CA ⑧

FA ⑨

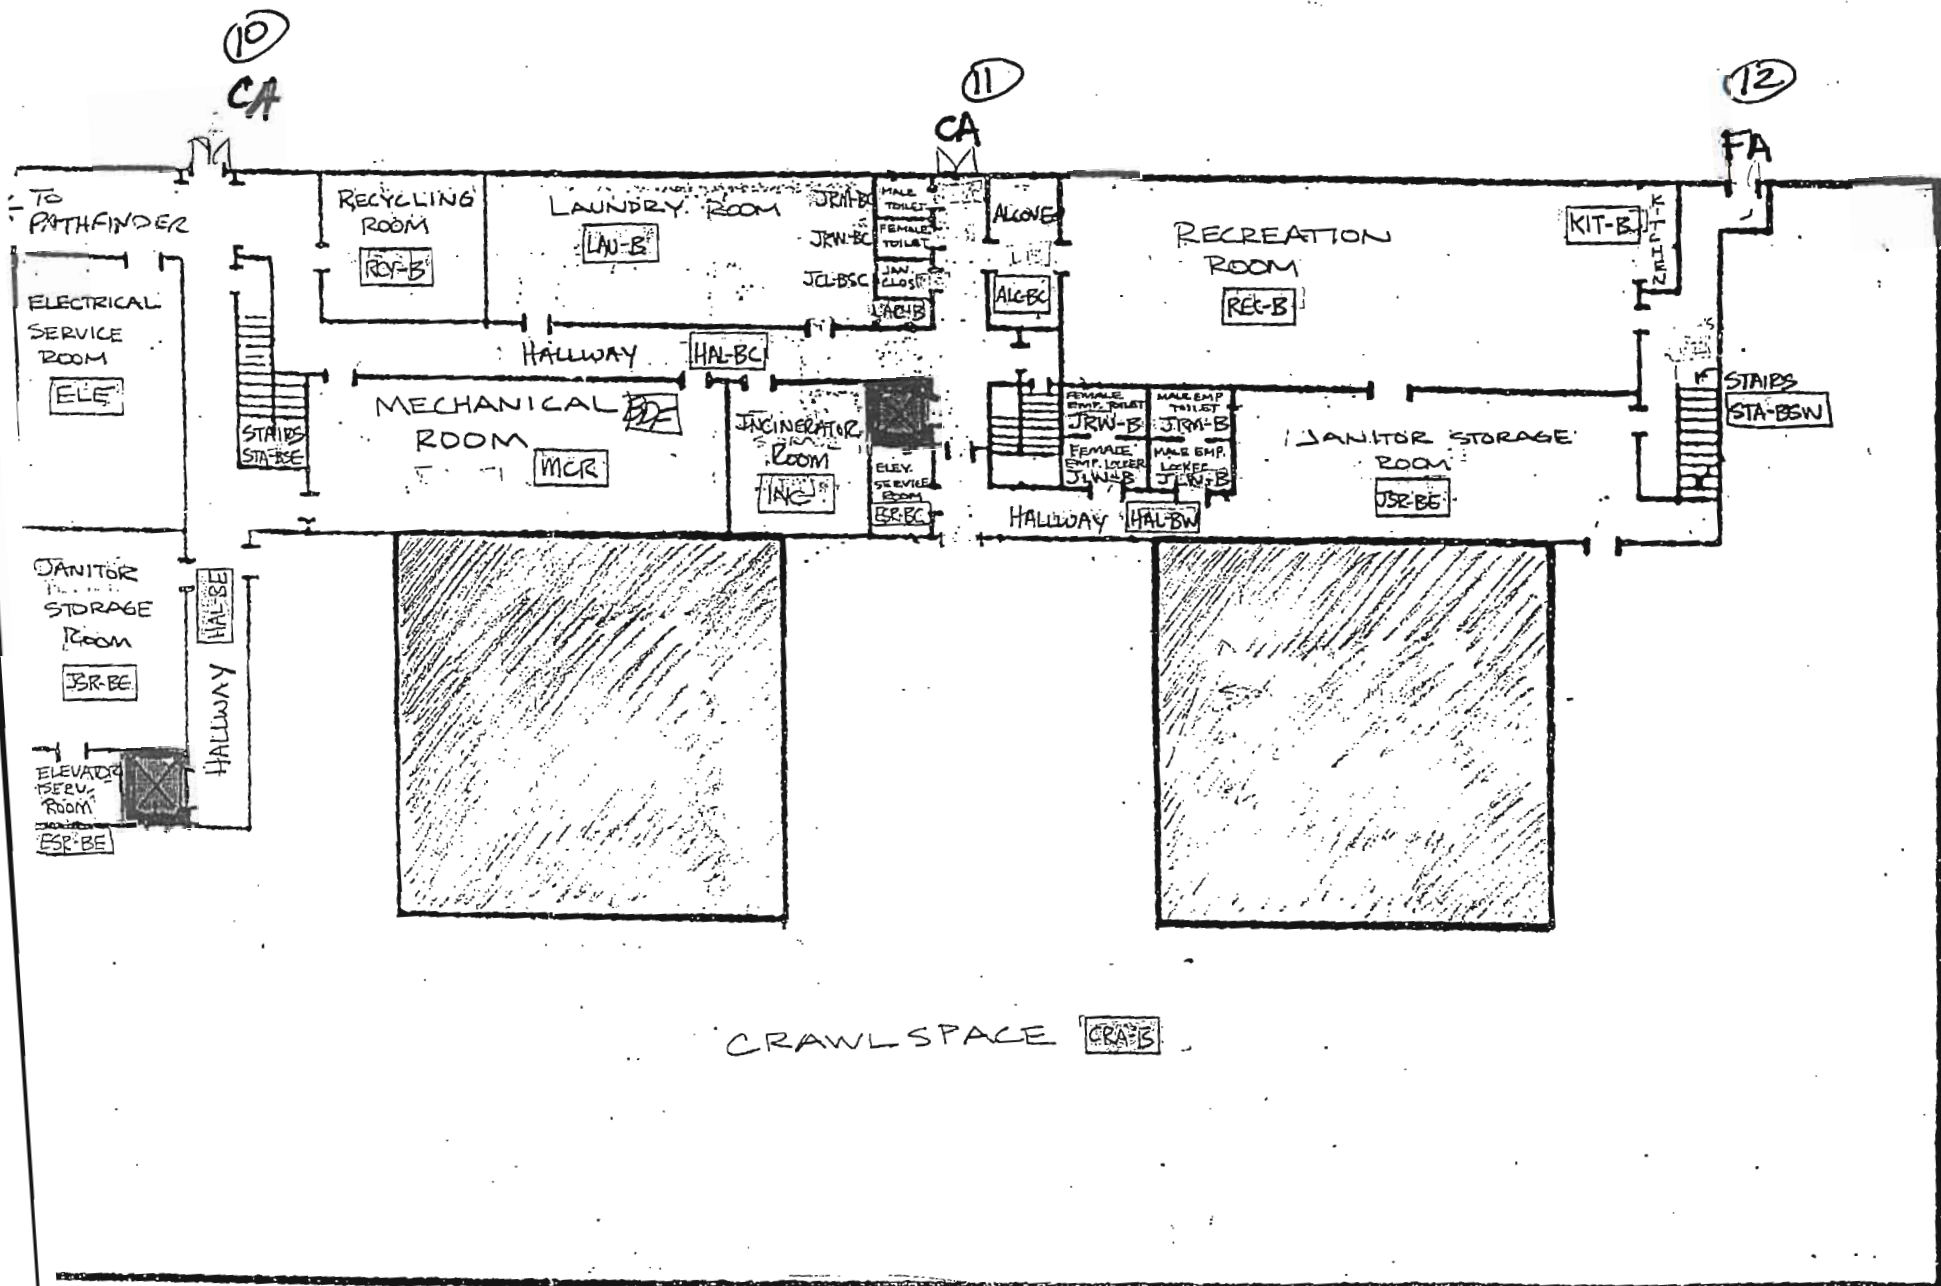


CAYUGA HALL - BASEMENT

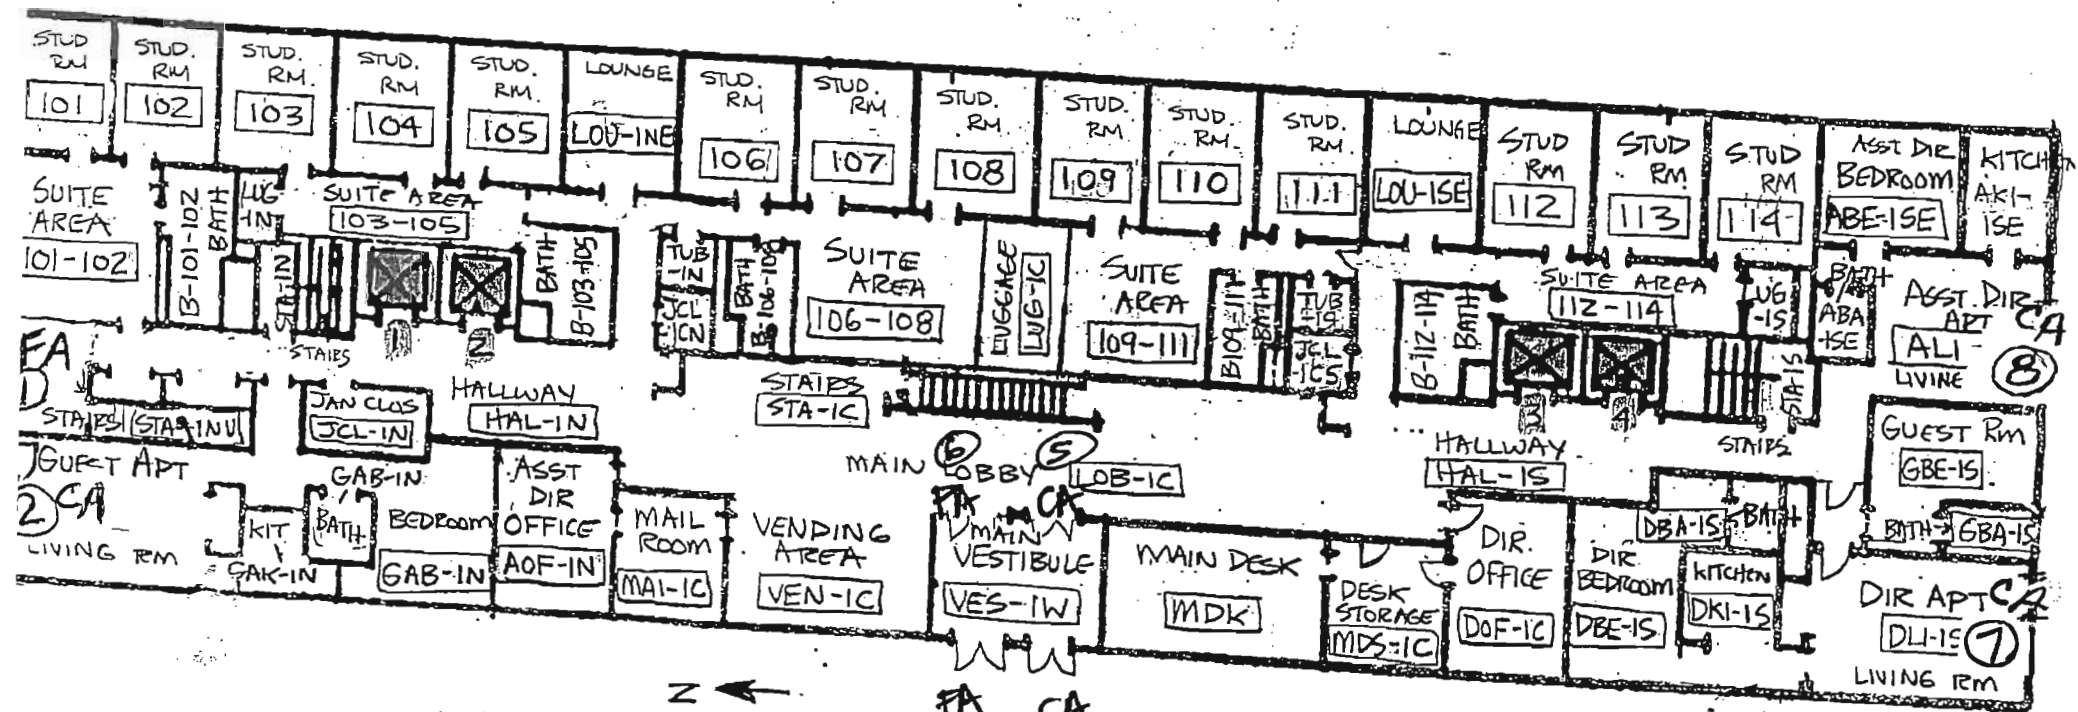

ONONDAGA HALL - 1ST FLOOR  
 BUILDING #34 STAGE X

TUNNEL  
TO  
LITTLE PAGE

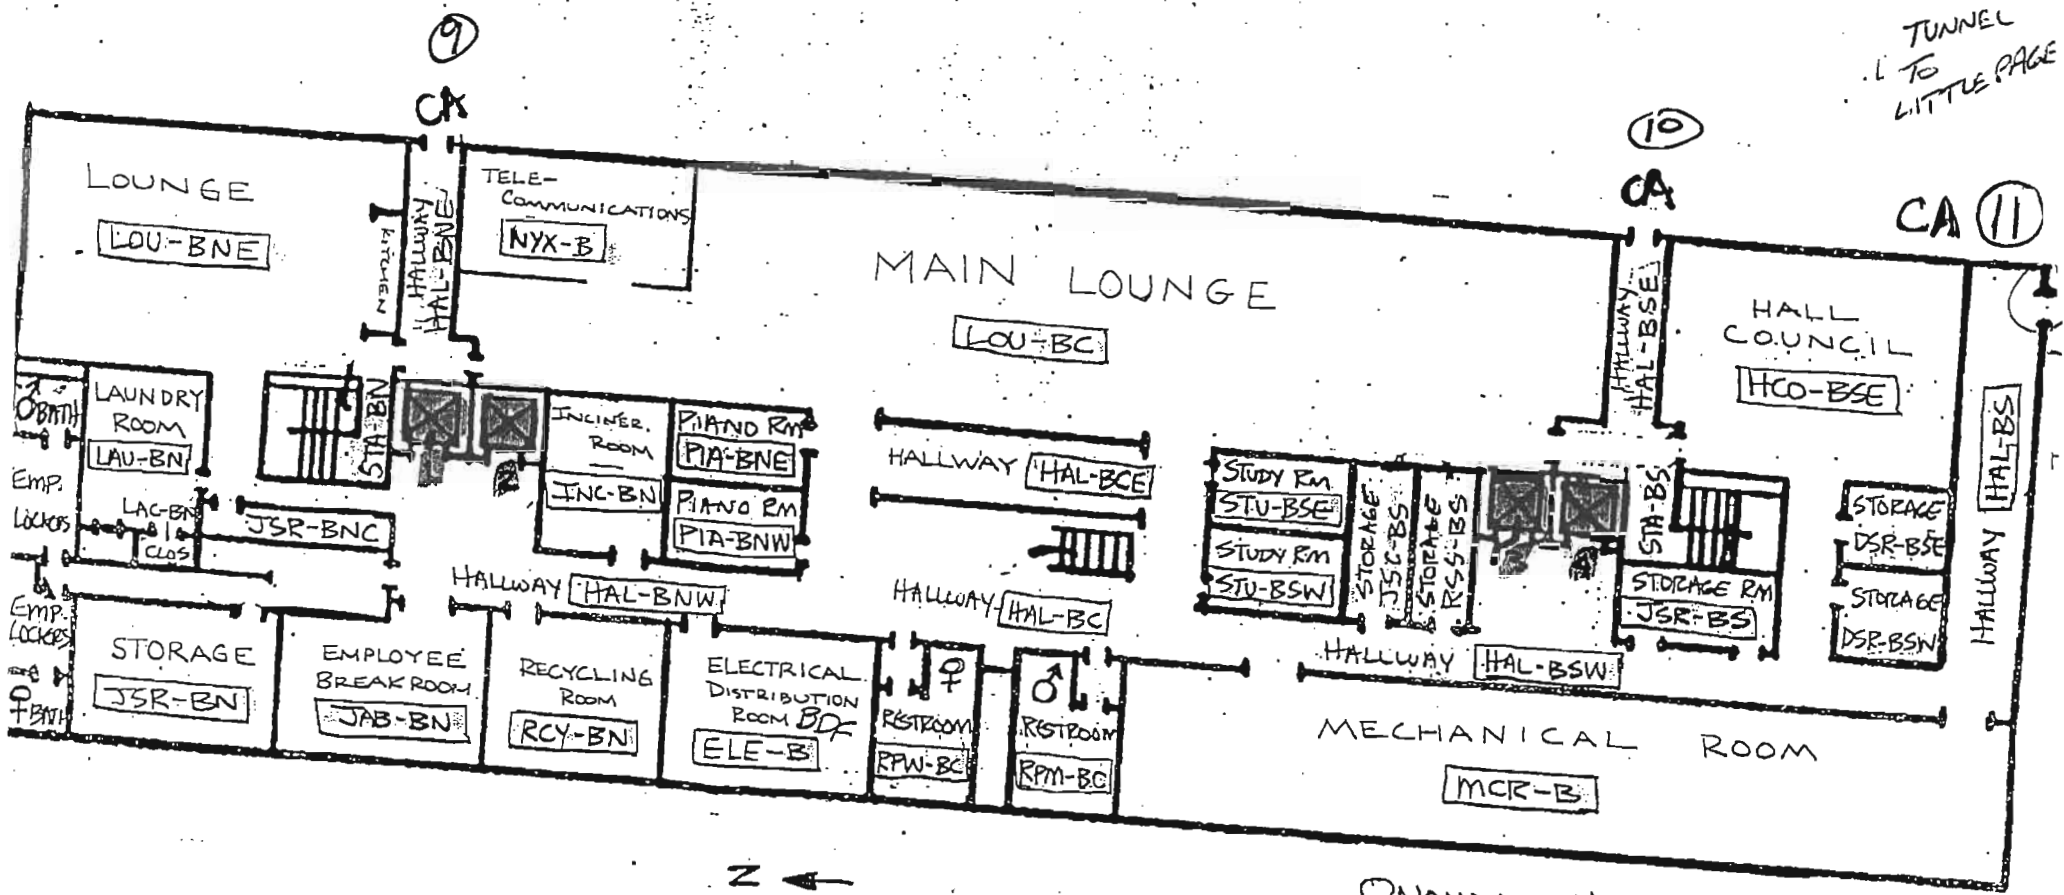

ONONDAGA HALL - BASEMENT  
BUILDING #3A STAGE X

BASEMENT

42'-9.1/2"

80'-0"

GLIMMERGLASS FIT CTR

FREE WEIGHTS AREA

AEROBICS AREA  
25'-8" x 42'-9"  
-1090 sq. ft.

MAIN AREA

115 GFC

FA 8

FA 7

FIT CTR NORTH CORRIDOR

FIT CTR SOUTH CORRIDOR

112 GFC  
MEN'S RESTROOM

113 GFC  
VEST. S.

STAIRS UP  
118 AM

STAIRS UP  
116 AM

119 GFC  
CHANGE AREA

120 GFC  
WOMEN'S RESTROOM

121 GFC  
FIT. DIR OFFICE

LOCKER AREA GFC  
109

JAN CLOSET  
114 AM

MECHANICAL ROOM

101 AM

FIT. CTR STORAGE AREA  
111 GFC

123 GFC

NAUTILUS EXERCISE EQUIPMENT AREA

106 GFC

CA 1

CA 5

FA 6

FA 4

124

NORTH TUNNEL  
TO ONONDAGA

BASEMENT CORRIDOR 106A

110

SOUTH TUNNEL  
TO ONEIDA


AUXILIARY SERVICES  
MTCE. STOP AREA

STAIRS UP  
TO  
DINING HALL

elec. BDF  
MECHANICAL  
AREA

BDF


LITTLEPAGE

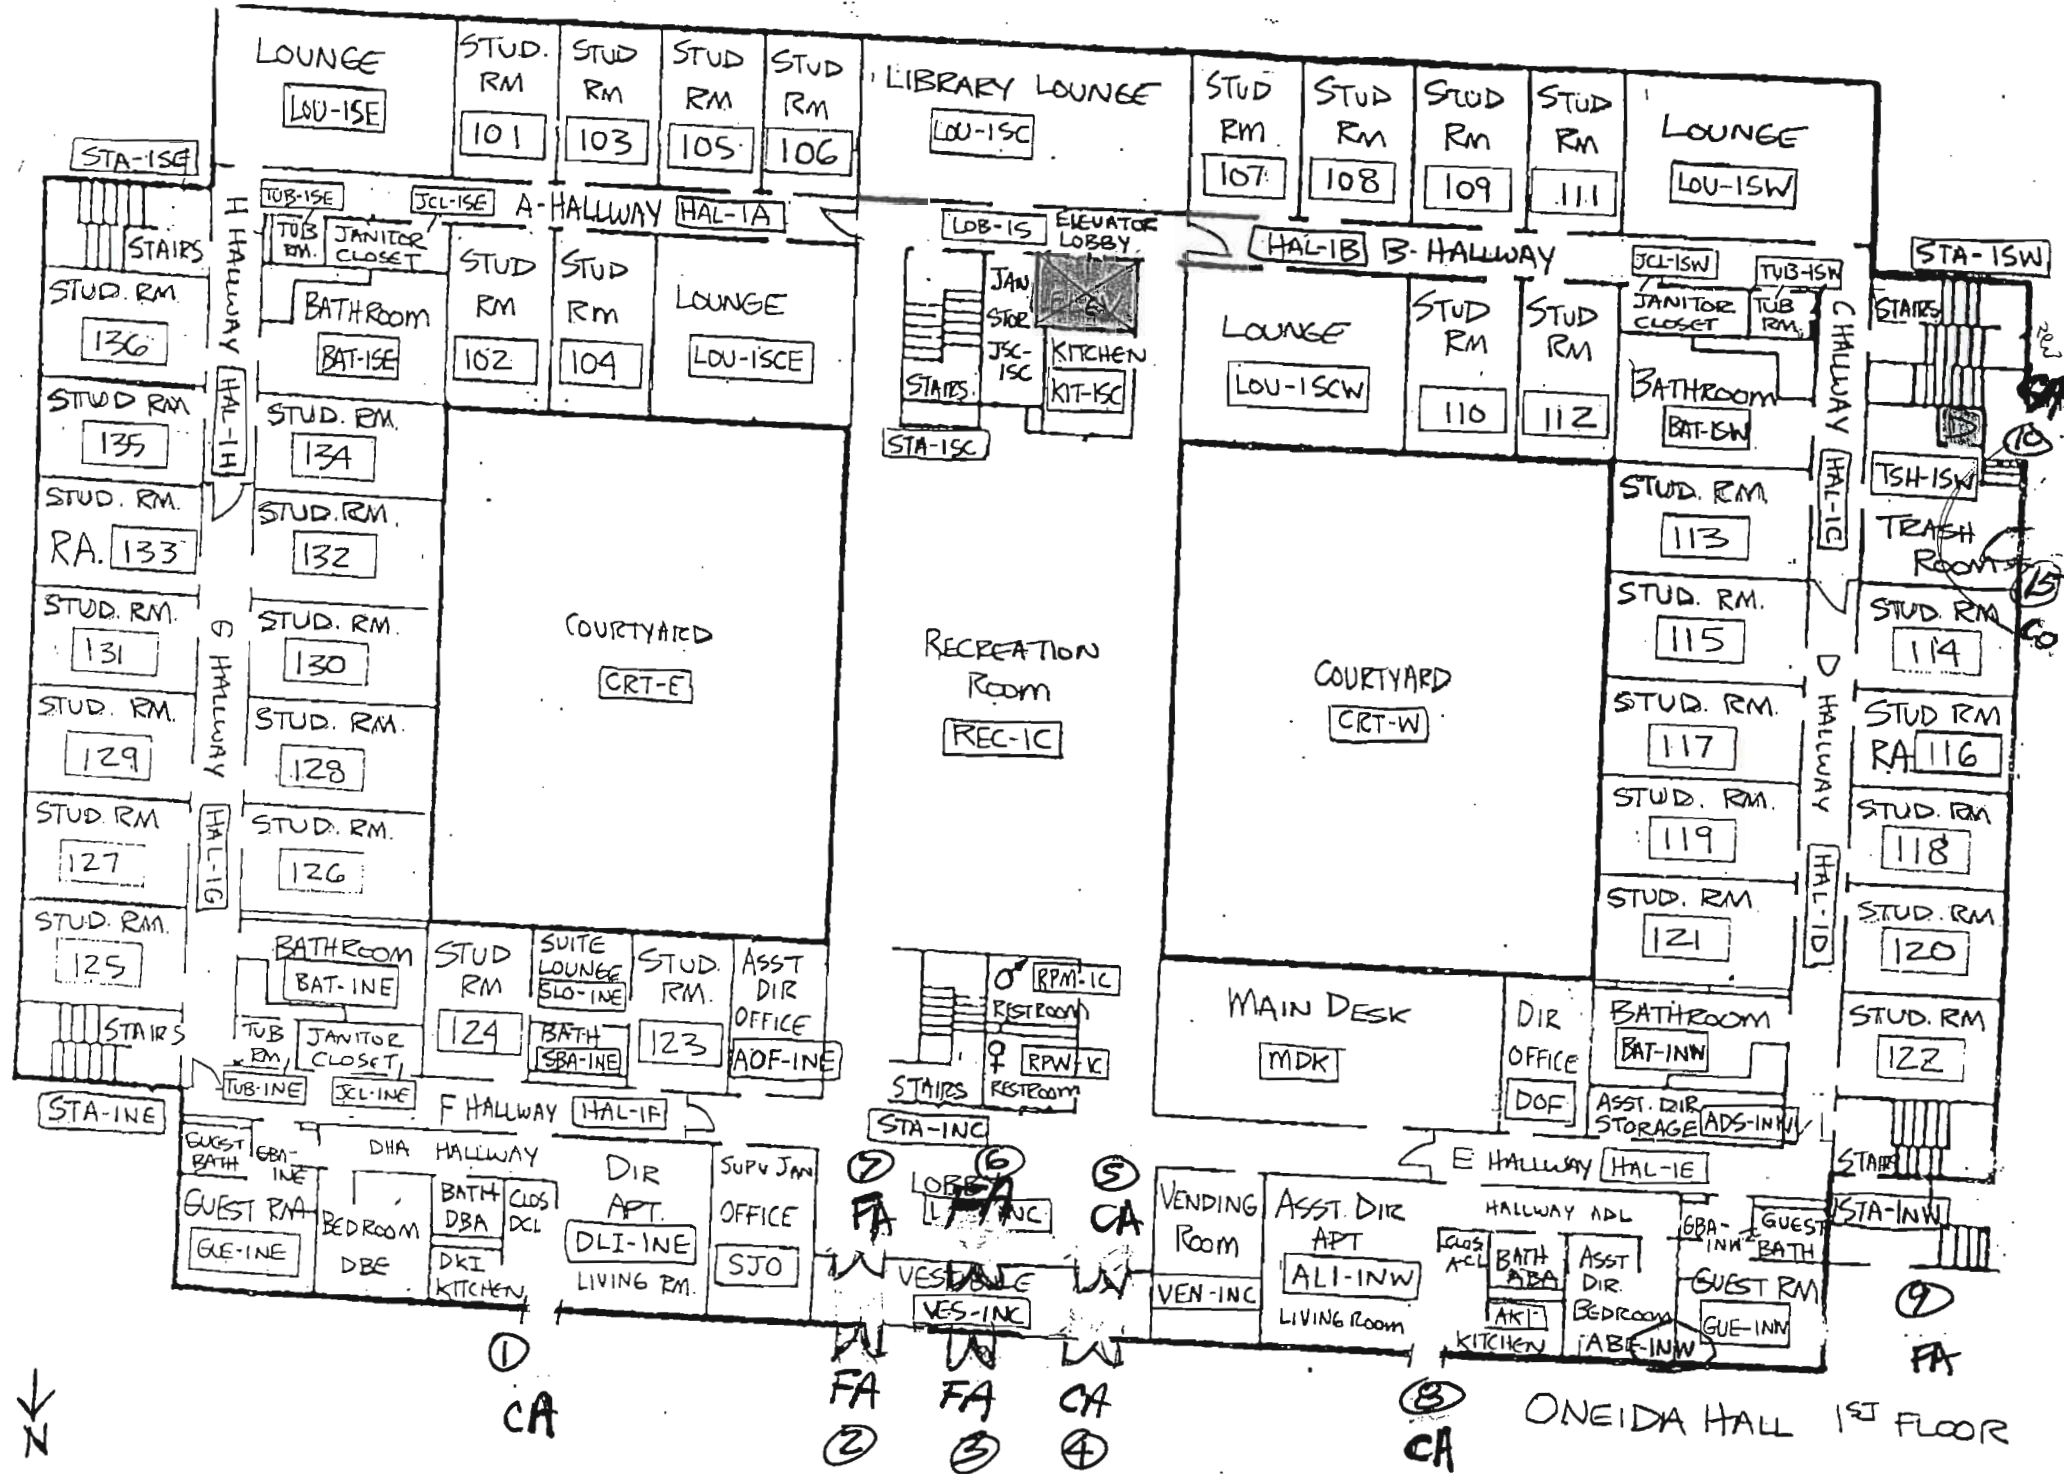

CA 13

14 CA

CA 12

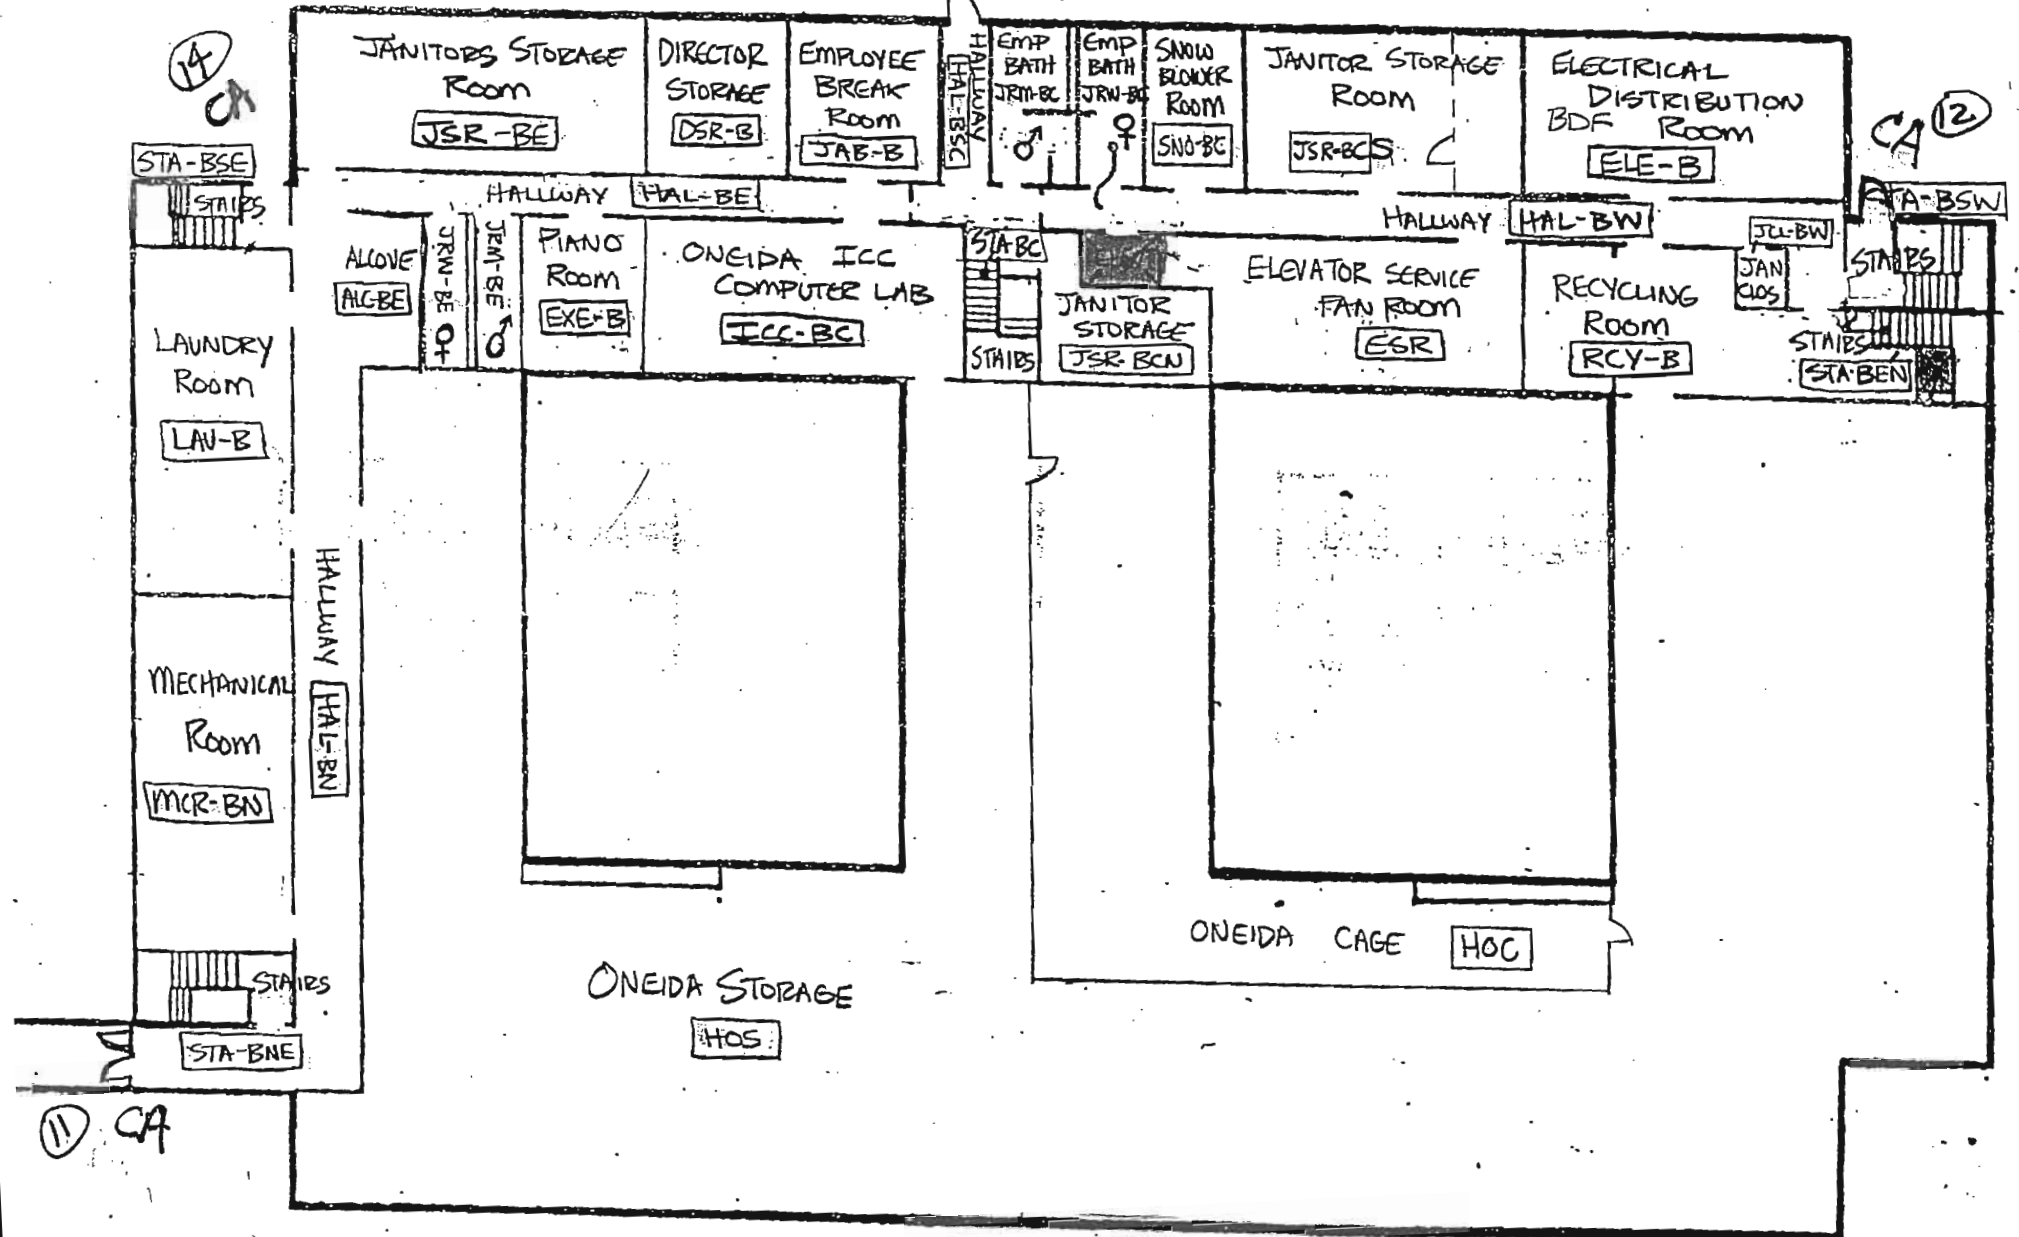


11 CA

TO LITTLEPAGE

ONEIDA HALL BASEMENT





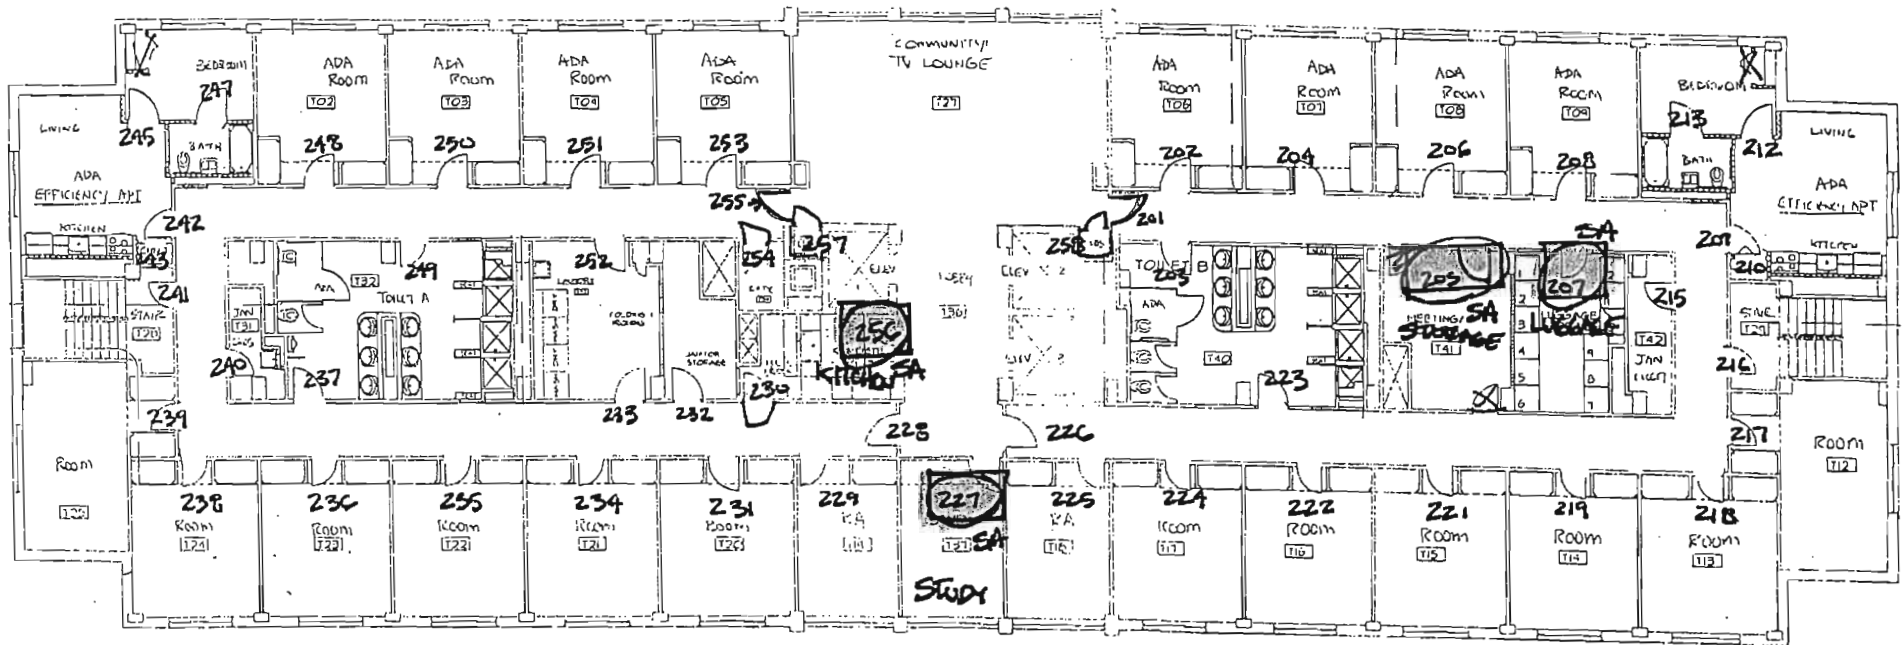


HART HALL - 2 & 3 ADA FLOORS

TYPICAL 4 - 9 FLOORS

(4) EACH FLOOR UPPER


STUDY, KITCHEN  
STORAGE, LUGGAGE

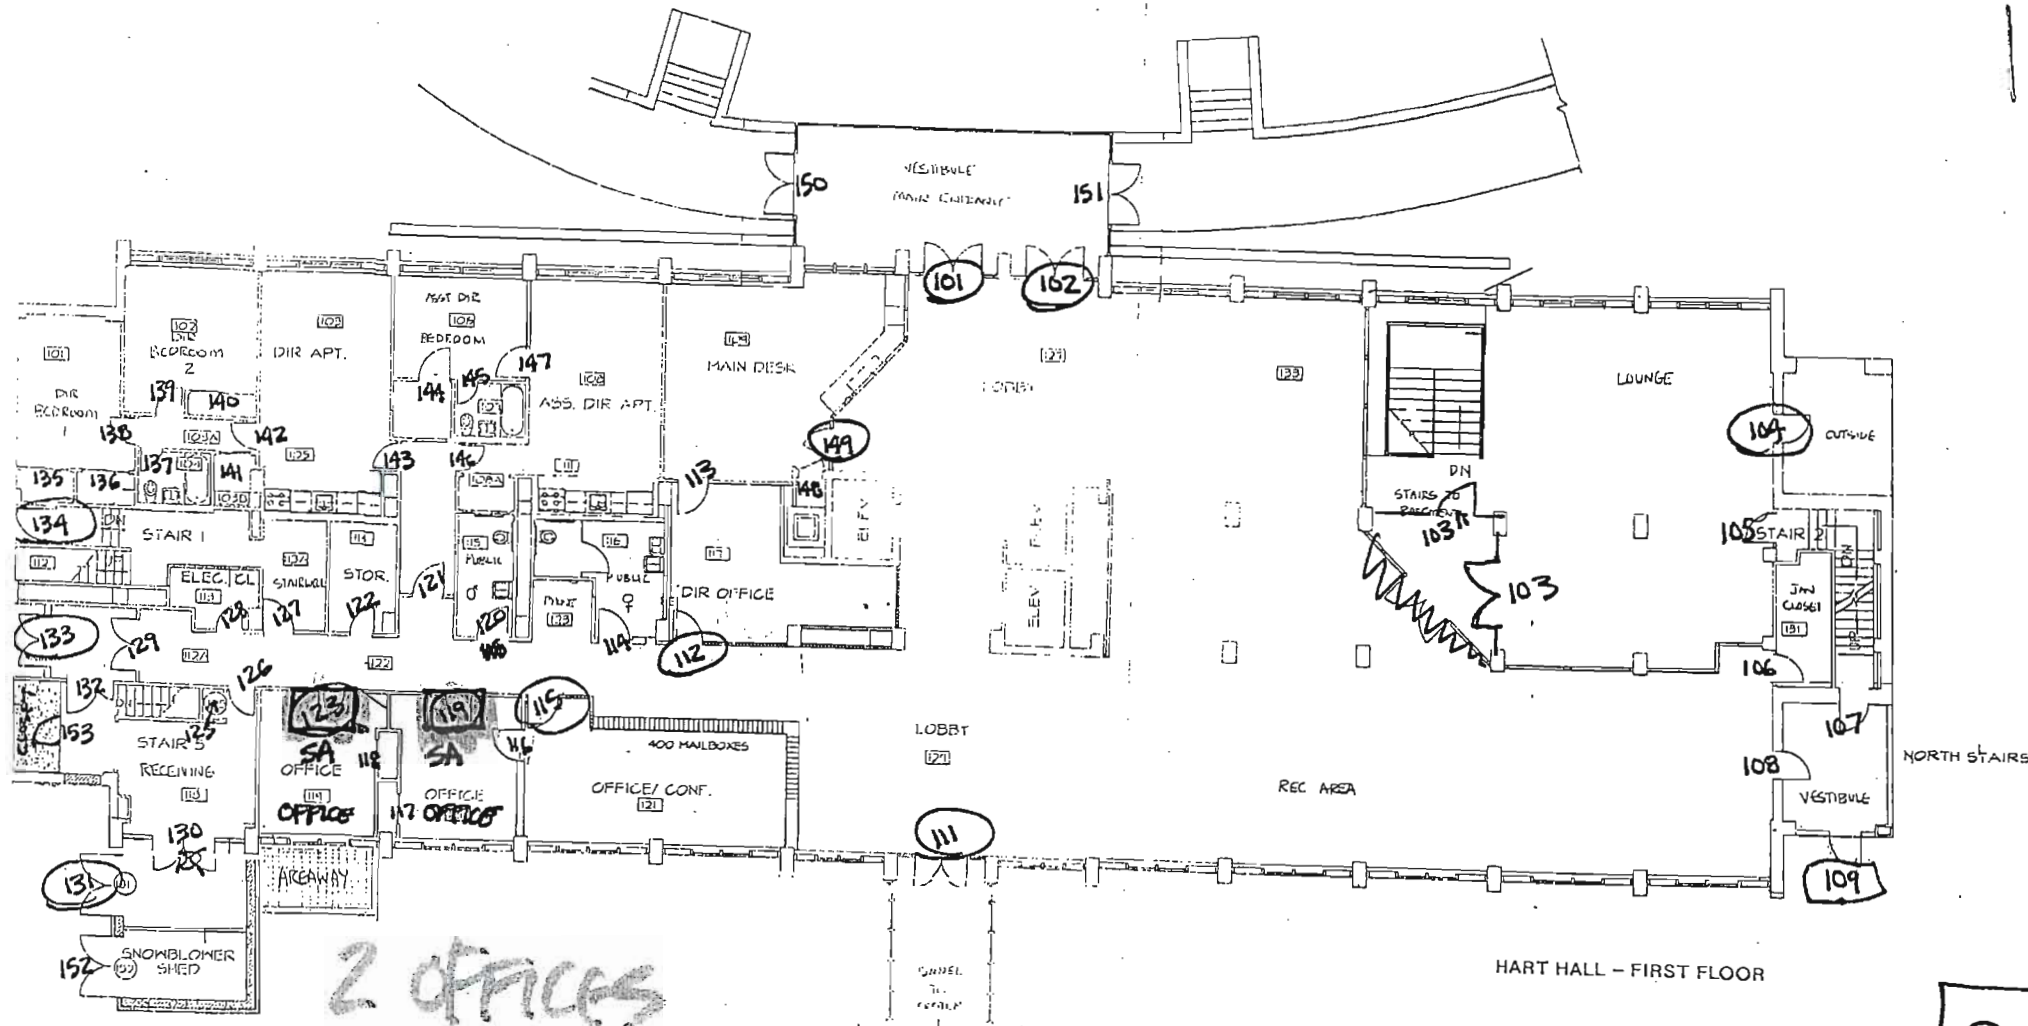


FLOOR	HW	SA	
FLOOR 1	11	2	
FLOOR B	2	0	
FLOOR 2-9	0	32	400 MAIL BOXES
TOTAL	12	34	

○ = HARDWIRED  
 □ SA = STAND ALONE BATTERY

HARDWIRED ACCESS  
 HART HALL

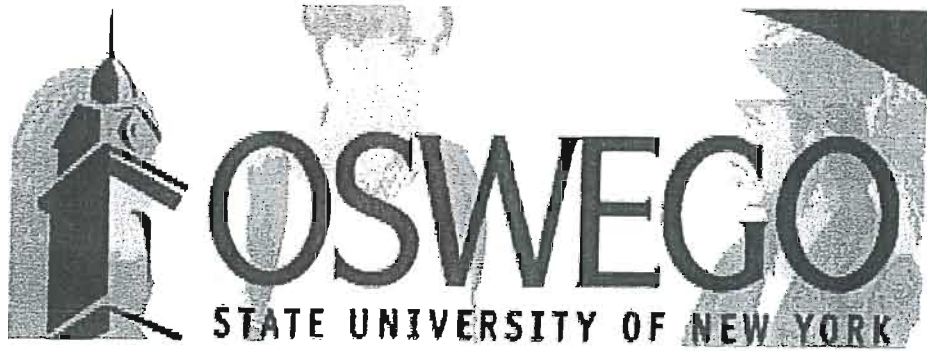


## **DOORS: LONIS HALL ACCESS CONTROL FEASIBILITY**

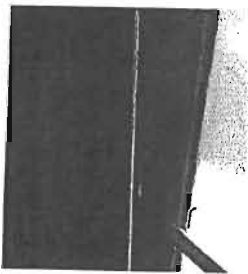


**Lonis Hall Door 1**



**Lonis Hall Door 2**

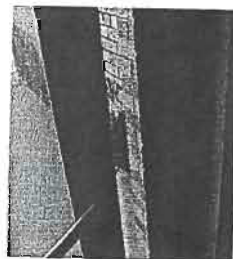

**Lonis Hall Door 3**

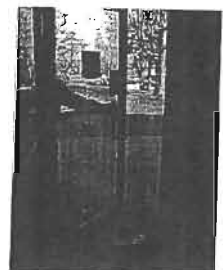

**Lonis Hall Door 4**




## **DOORS: MAKIN DINING CENTER ACCESS CONTROL FEASIBILITY**



**Makin Dining Center Door 1**



**Makin Dining Center Door 4-7**

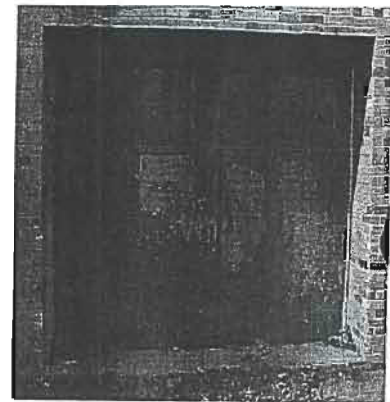

**Makin Dining Center Door 9**



**Makin Dining Center Door 10**



**Makin Dining Center Door 12**



## **DOORS: MORELAND HALL ACCESS CONTROL FEASIBILITY**




**Moreland Hall Door 1**




**Moreland Hall Door 3**




**Moreland Hall Door 4**

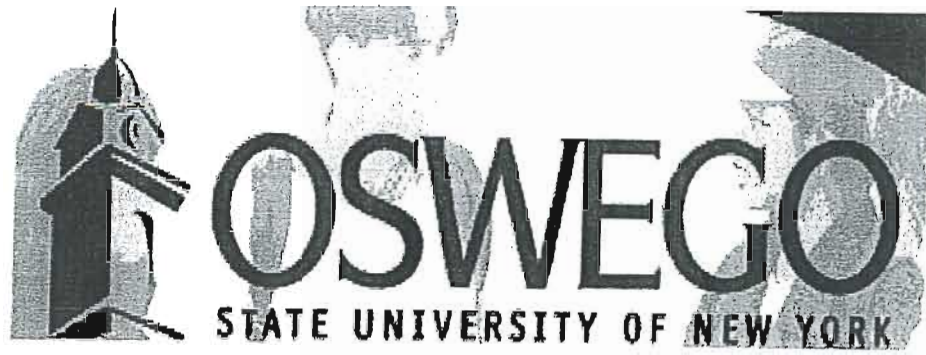


## **DOORS: FUNNELLE HALL ACCESS CONTROL FEASIBILITY**

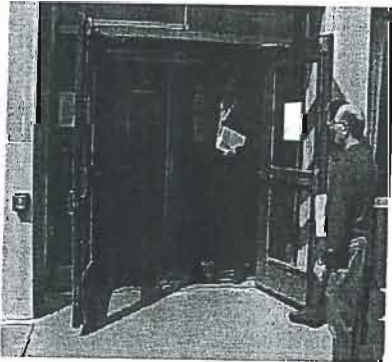

**Funnelle Hall Door 4**

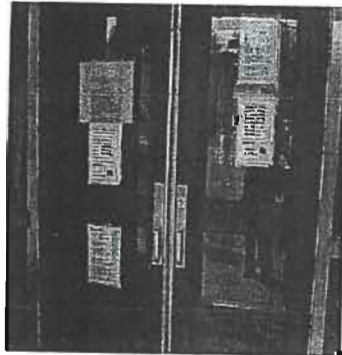


**Funnelle Hall Door 5**

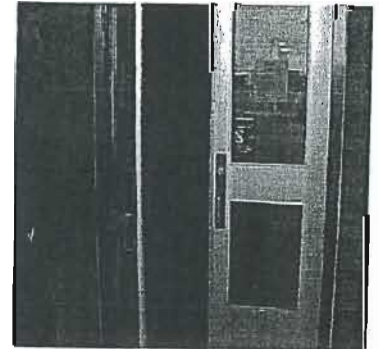

**Funnelle Hall Door 7**




## **DOORS: COOPER DINING HALL ACCESS CONTROL FEASIBILITY**

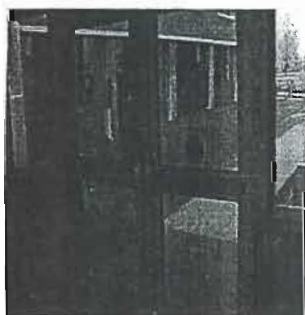

**Cooper Dining Hall Door 1**



**Cooper Dining Hall Door 2**

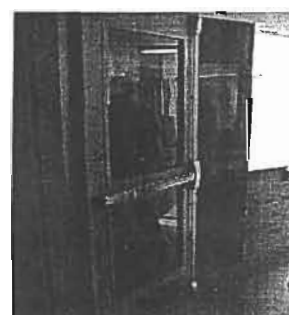


**Cooper Dining Hall Door 3**



## **DOORS: HART HALL ACCESS CONTROL FEASIBILITY**




**Hart Residence Hall Door 7**

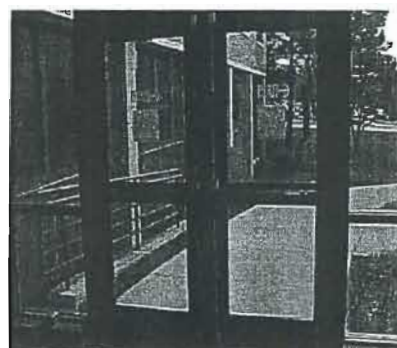

**Hart Residence Hall Door 10**



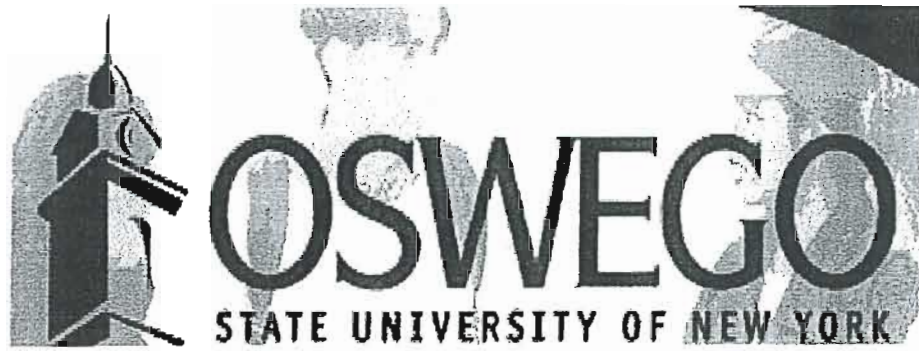

## DOORS: SENECA HALL ACCESS CONTROL FEASIBILITY




**Seneca Hall Door 2  
(apartment)**



**Seneca Hall Door 7**



**Seneca Hall Door 8**

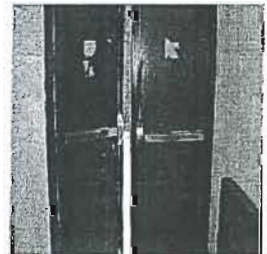

**Seneca Hall Door 9**



**Seneca Hall  
Door 10**




**Seneca Hall Door 34**



**Seneca Hall Door 56**



## **DOORS: PATHFINDER DINING CENTER ACCESS CONTROL FEASIBILITY**

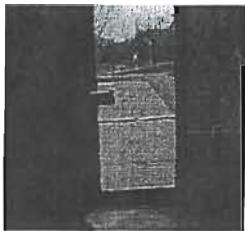


**Pathfinder Dining Center  
Door 2**



**Pathfinder Dining Center  
Door 5**



**Pathfinder Dining Center  
Door 6**

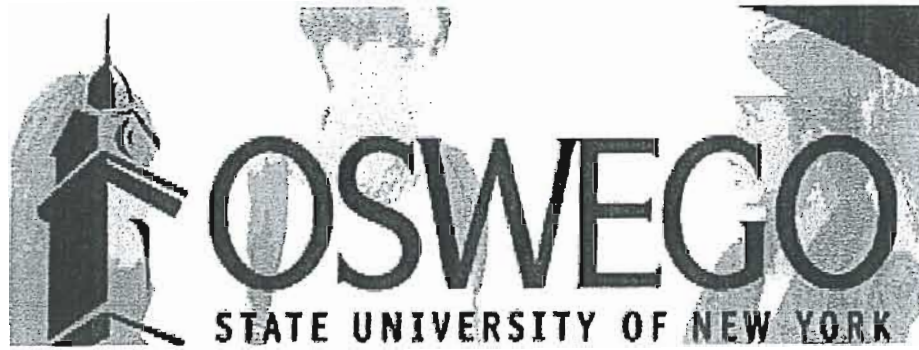

## DOORS: CAYUGA HALL ACCESS CONTROL FEASIBILITY



Cayuga Hall Door 1



Cayuga Hall Door 3




Cayuga Hall Doors 4-5




Cayuga Hall Doors 6-7



Cayuga Hall Door 10

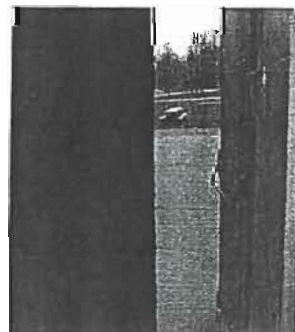

Cayuga Hall Door 11

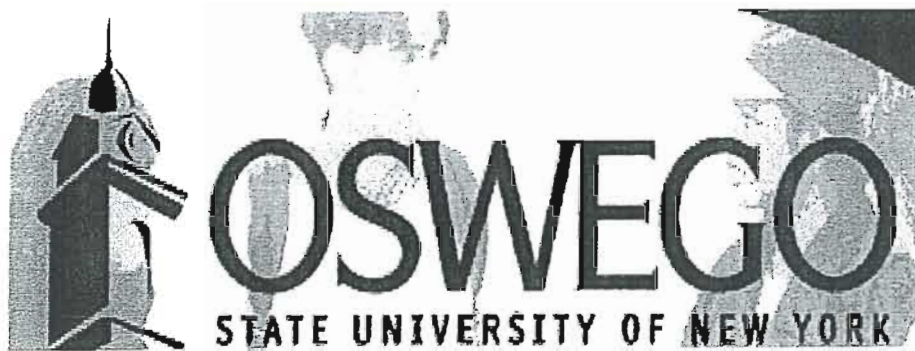

## DOORS: ONONDAGA HALL ACCESS CONTROL FEASIBILITY



Onondaga Hall Door 1



Onondaga Door 2




Onondaga Hall Door 3-4




Onondaga Hall 5-6



Onondaga Hall Door 7

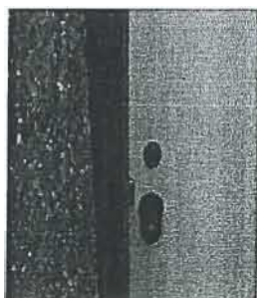


Onondaga Hall Door 8

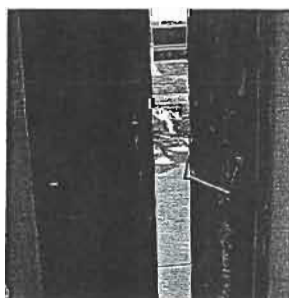

Onondaga Hall Door 9



Onondaga Hall Door 10

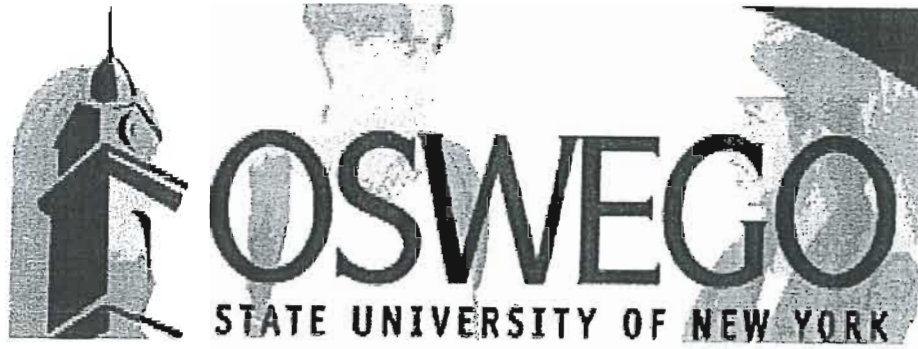

## DOORS: LITTLEPAGE DINING CENTER ACCESS CONTROL FEASIBILITY




Littlepage Dining Center  
Door 1



Littlepage Dining Center  
Door 2



Littlepage Dining Center  
Door 3

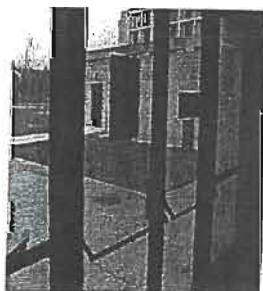

Littlepage Dining Center  
Door 7 (Gym)



Littlepage Dining Center  
Door 8 (Gym)



## DOORS: ONEIDA HALL ACCESS CONTROL FEASIBILITY



Oneida Hall Door 2-7



Oneida Hall Door 10



Oneida Hall Door 11



Oneida Hall Door 12




Oneida Hall Door 13



Oneida Hall Door 14




## **DOORS: SCALES HALL ACCESS CONTROL FEASIBILITY**

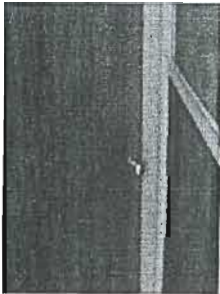

**Scales Hall Door 1**



**Scales Hall Door 2**

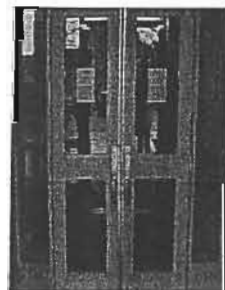


**Scales Hall Door 3**




**Scales Hall Door 5**



**Scales Hall Door 7**

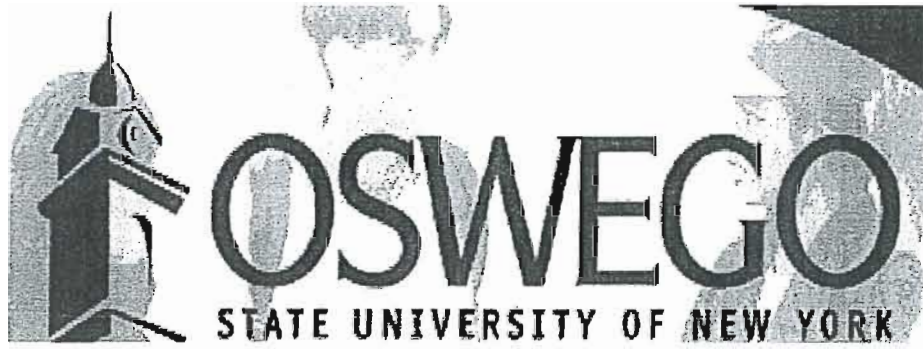


## **DOORS: WATERBURY HALL ACCESS CONTROL FEASIBILITY**

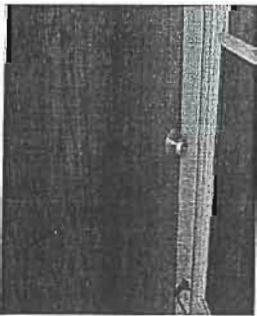

**Waterbury Hall Door 1**




**Waterbury Hall Door 2**

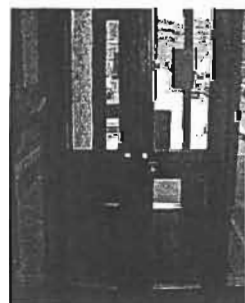


**Waterbury Hall Door 3**



**Waterbury Hall Door 4**

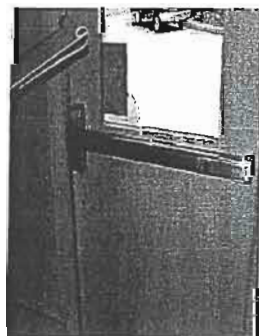


**Waterbury Hall Door 5**

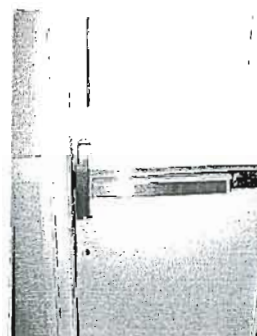


**Waterbury Hall Door 8**



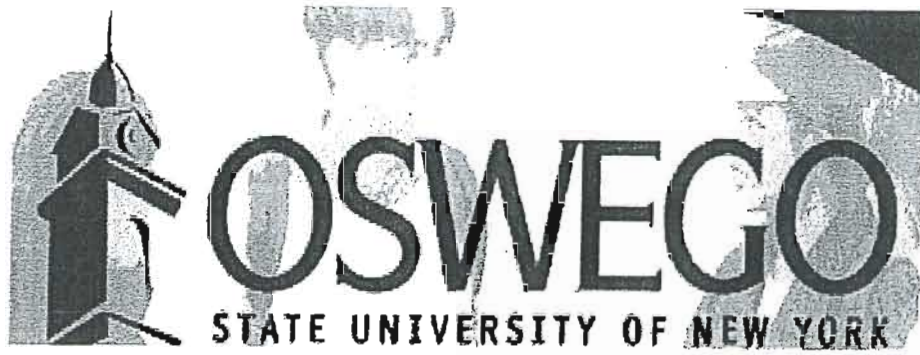

## **DOORS: JOHNSON HALL ACCESS CONTROL FEASIBILITY**

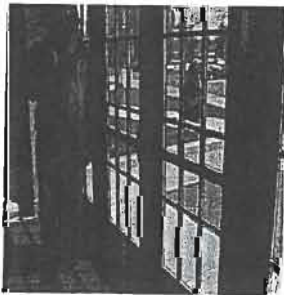

**Johnson Hall Door 1  
(outside, main door)**



**Johnson Hall  
Site of future Door 2**



**Johnson Hall Door 3  
(Inside, main door)**